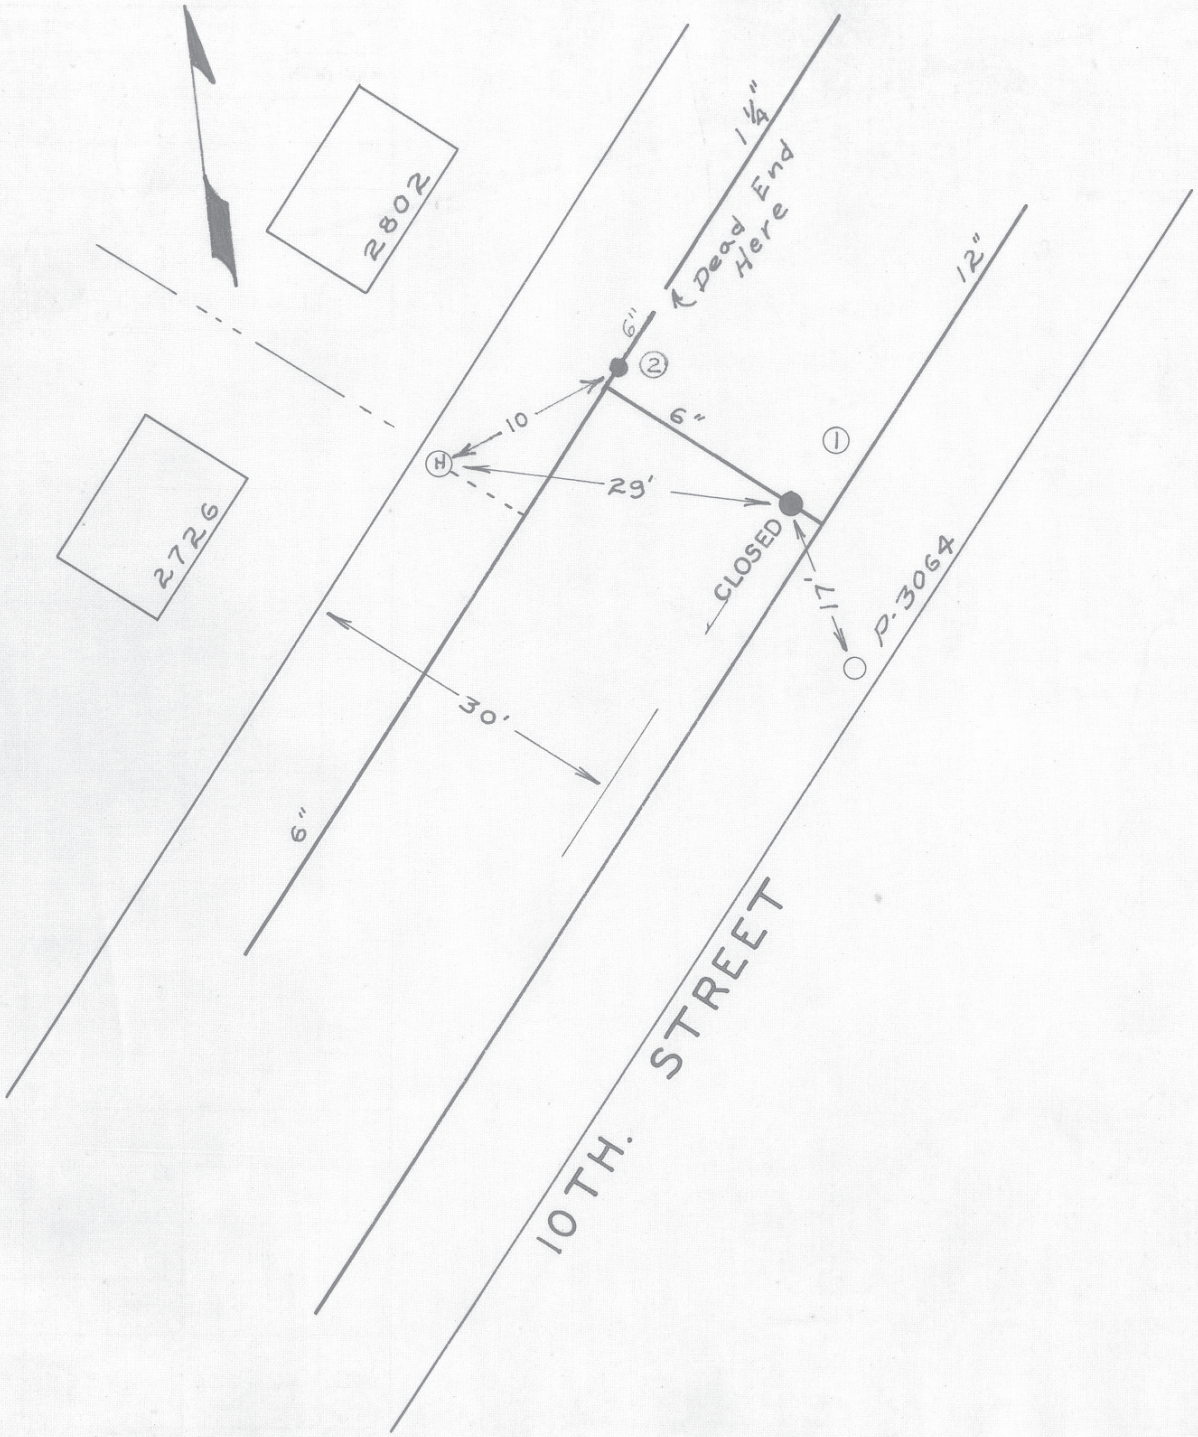

DATE	NO.	SIZE	MAKE	OPEN	TURNS
	1	6"			
5-67	2	6"		R	21
	1	305'-N	NPL	Hillcrest Ave.	

CITY OF ROANOKE — WATER DEPT.

VALVE DIAGRAM

-10TH. ST. 300'-N. OF

HILLCREST AVE. N. W.

SEC. MAP 208, 207

DATE PAGE NO.