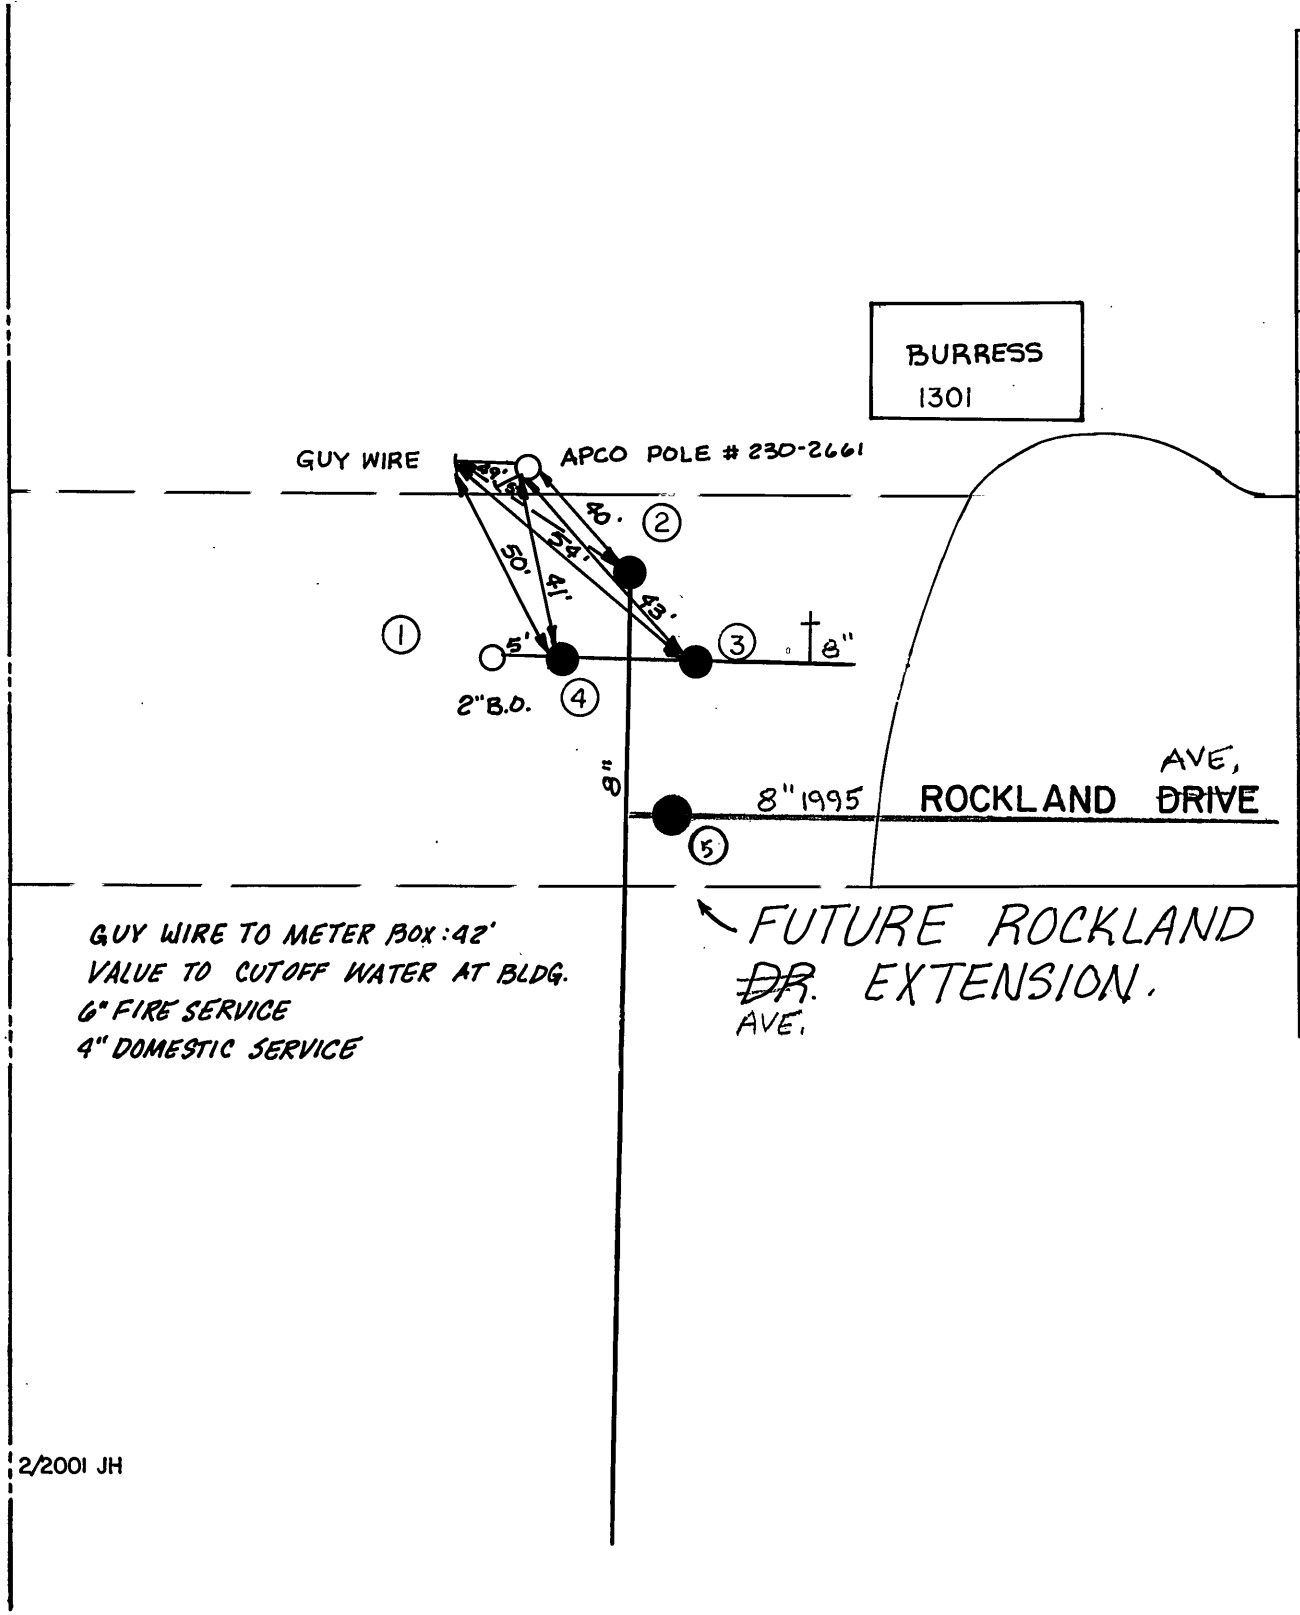

DATE	NO.	SIZE	MAKE	OPEN	TURNS
11-81	1	2"	BLOW-OFF		
11-81	2	8"	MUELLER		
1981	3	8"			
1981	4	8"			
6/1994	5	8"	Mueller	R	27

2/2001 JH

CITY OF ROANOKE—WATER DEP'T

VALVE DIAGRAM

ROCKLAND ~~DR.~~ AVE.

SEC. MAP 213, N.W.

DATE ≈1982 PAGE NO.