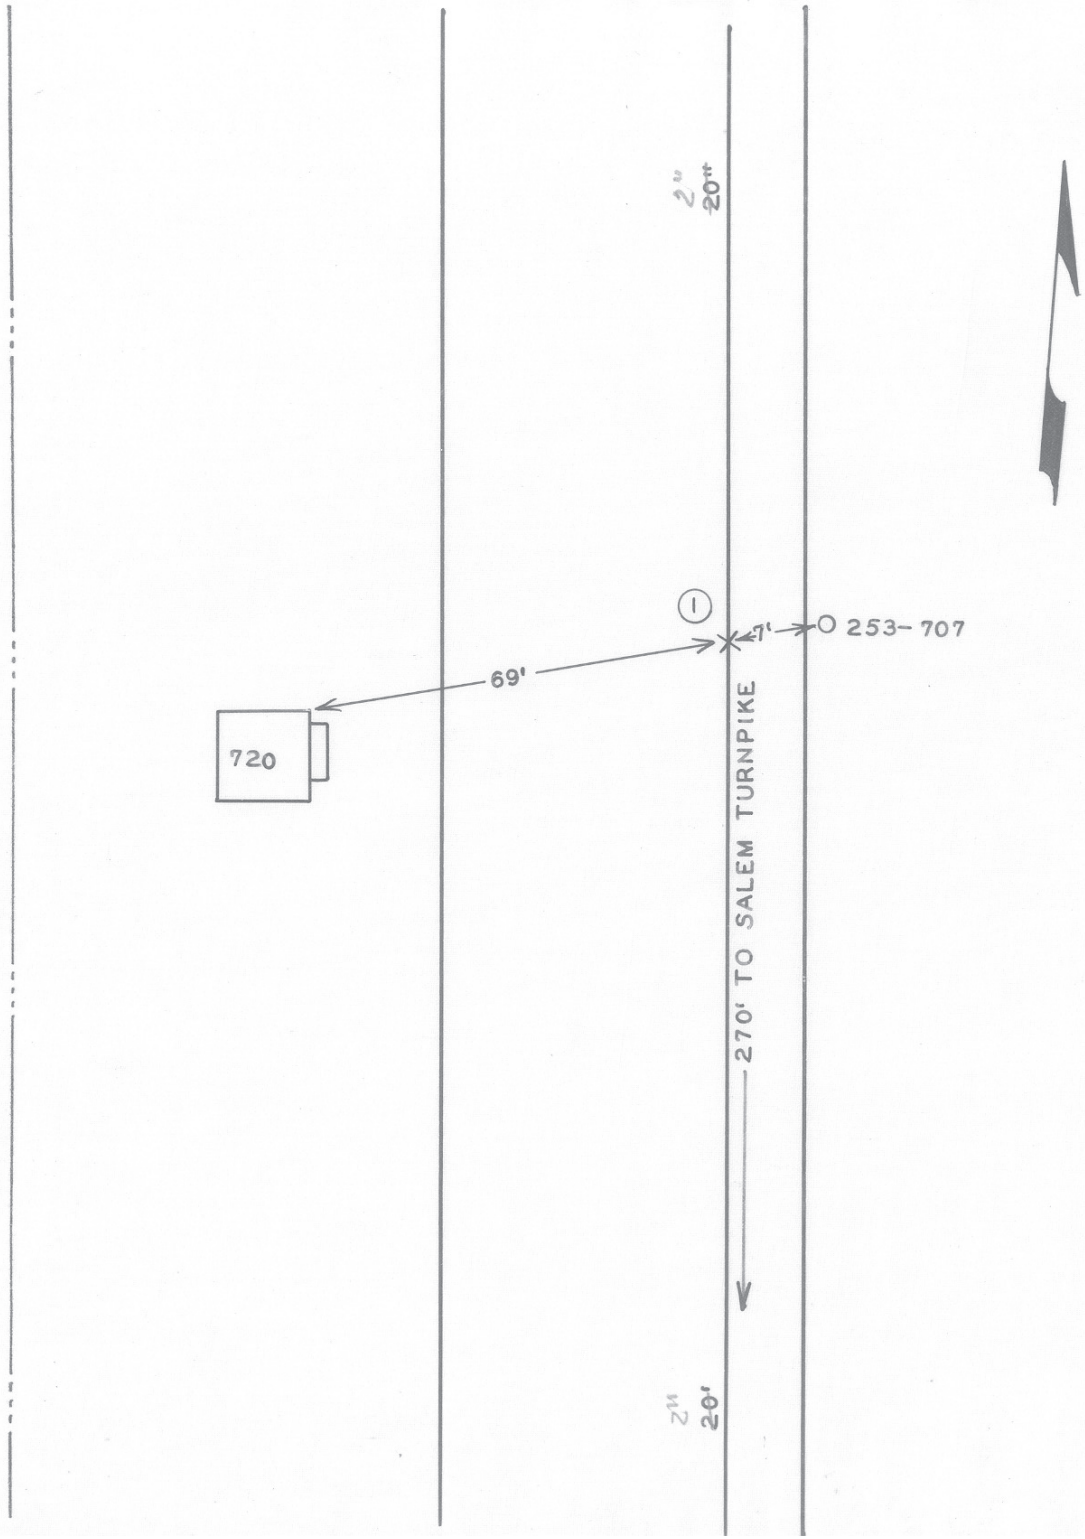

DATE	NO.	SIZE	MAKE	OPEN	TURNS
12-64	1	$1\frac{1}{2}$"	AIR VALVE		

CITY OF ROANOKE—WATER DEPT.

VALVE DIAGRAM

29TH STREET N.W.

SEC. MAP 242

DATE PAGE NO.