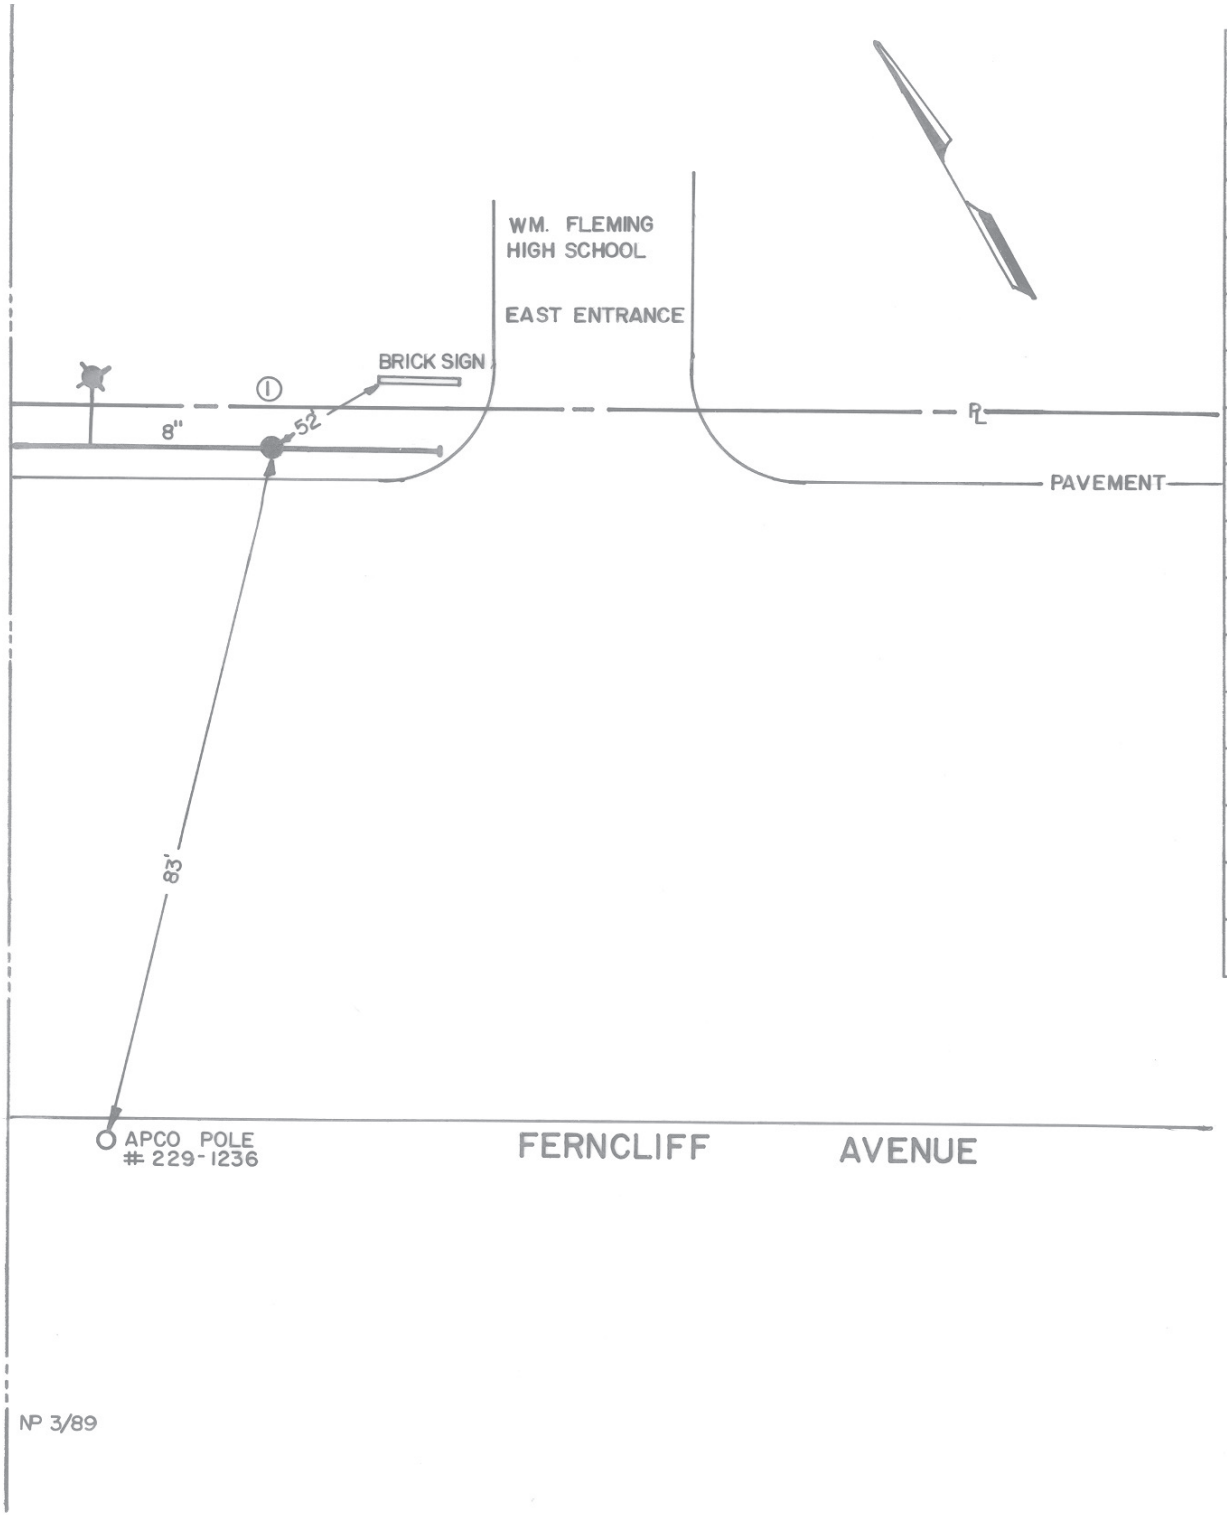

DATE	NO.	SIZE	MAKE	OPEN	TURNS
12-87	1	8"	DARLING	R	

CITY OF ROANOKE—WATER DEP'T

VALVE DIAGRAM

3649 FERNCLIFF AVE.

WM. FLEMING HIGH SCHOOL

N.W.

SEC. MAP 646

DATE PAGE NO.