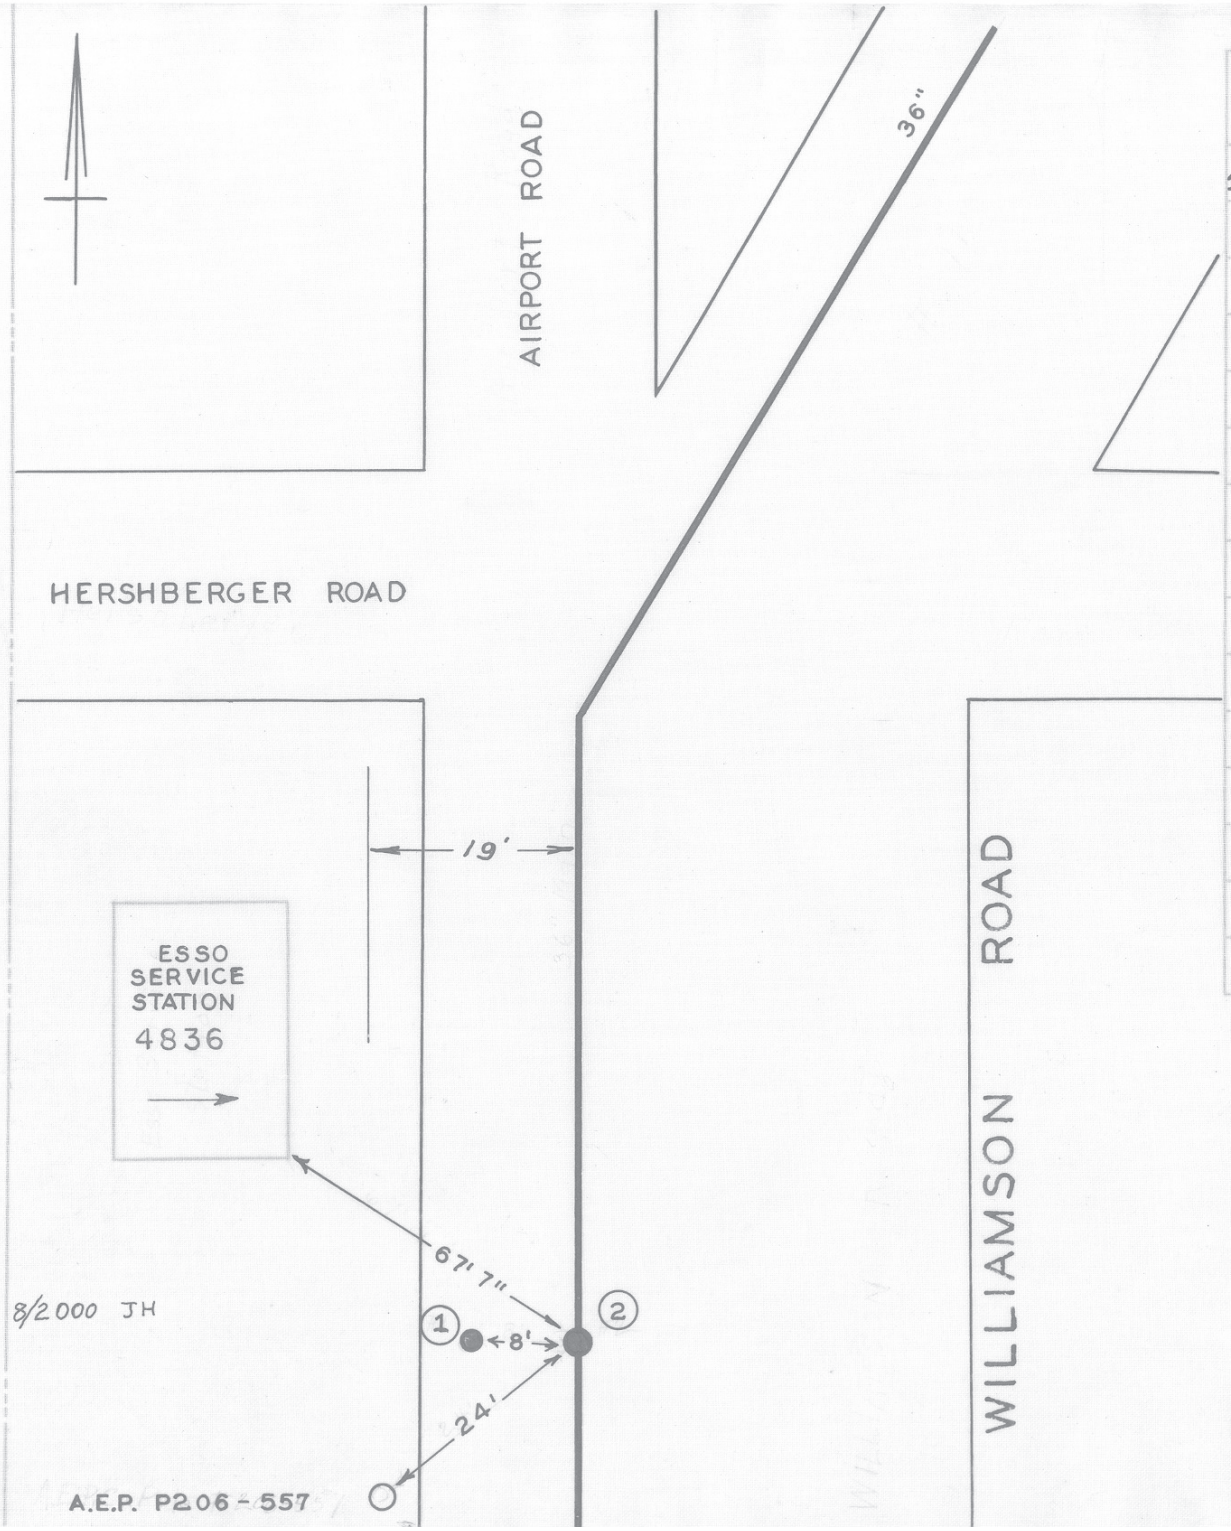


| DATE | NO. | SIZE | MAKE | OPEN | TURNS |
|---|---|---|---|---|---|
| 1946 | 1 | 4" | BY PASS | L | 9 |
| 1946 | 2 | 30" | M. & H. | L | 125 |
| | | | | | |
| | | | | | |
| | 1 | 110'-S | SPL | | |
| | | | | | |

CITY OF ROANOKE—WATER DEP'T

VALVE DIAGRAM

4800's OF WILLIAMSON &
110'-S OF HERSHBERGER
ROAD N.W.

SEC. MAP 217

DATE

PAGE NO. ~~NE119~~