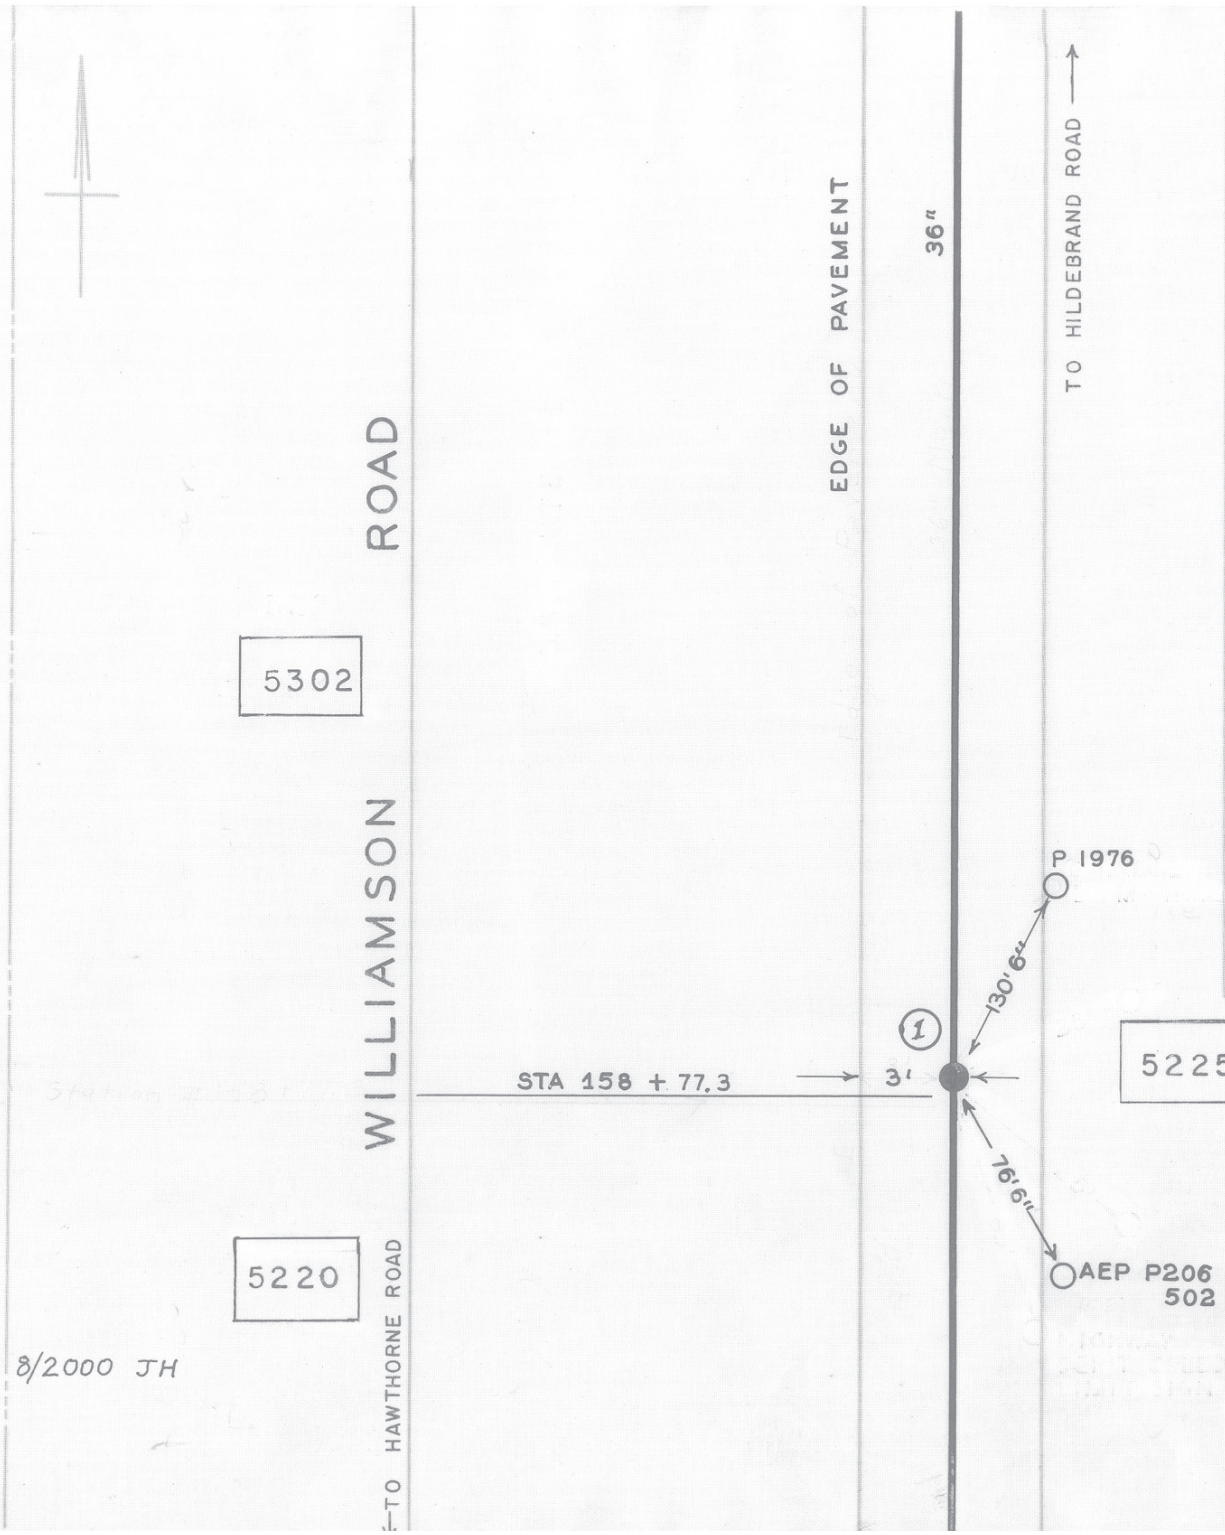

DATE	NO.	SIZE	MAKE	OPEN	TURNS
1946	1	1"	SIMPLEX	AIR	VALVE

Reset So. Monument
8" Pipe in Concrete

CITY OF ROANOKE—WATER DEP'T
VALVE DIAGRAM

5200 BLK. WILLIAMSON RD.
1,808.7' NORTH OF AIR VALVE
AT N. S. HERSHBERGER RD.

SEC. MAP 219 N.W.

DATE PAGE NO.

8/2000 JH