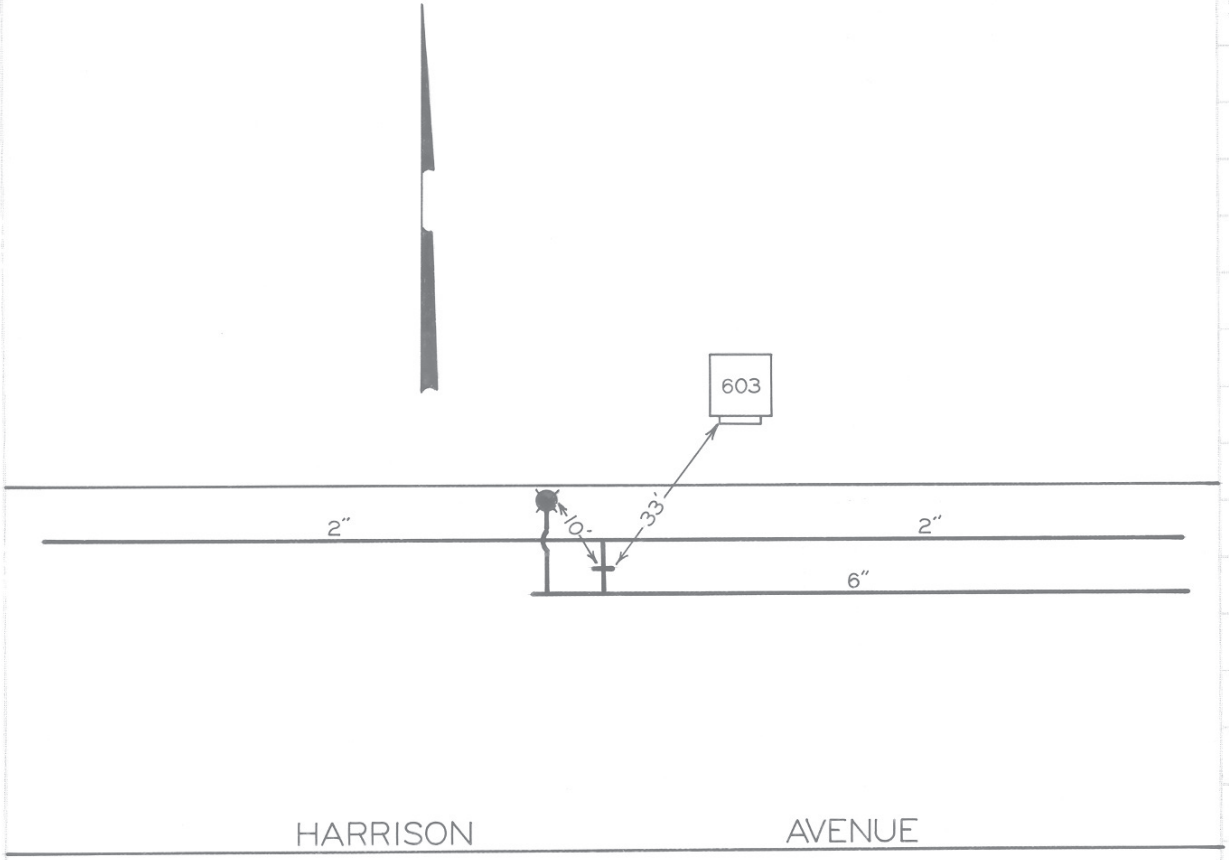

DATE	NO.	SIZE	MAKE	OPEN	TURNS
73	1	2"	MISC.		

CITY OF ROANOKE—WATER DEP'T

VALVE DIAGRAM

600 BLK. HARRISON AVE. N.W.

SEC. MAP 201

DATE PAGE NO.