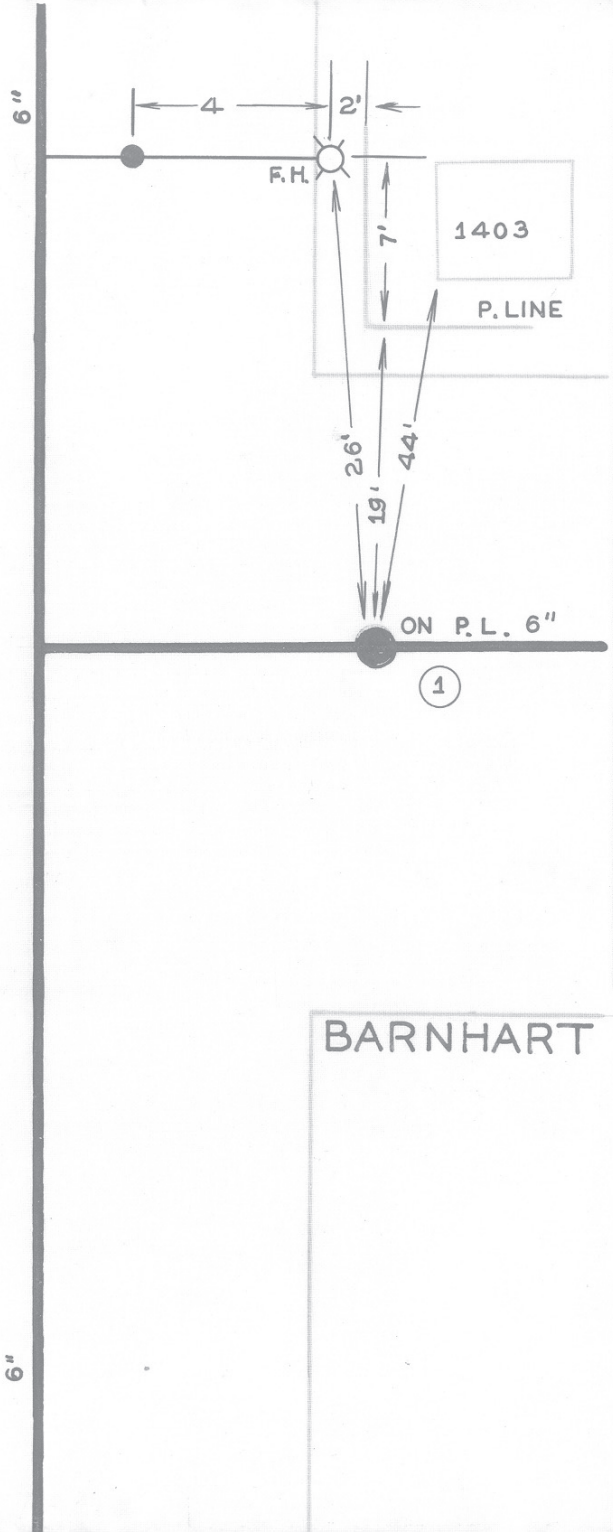

DATE	NO.	SIZE	MAKE	OPEN	TURNS
1949	1	6"	DARLING	R	21
	1	0	EPL		

ABBOTT ST.

BARNHART AVE.

CITY OF ROANOKE—WATER DEP'T

VALVE DIAGRAM

ABBOTT STREET &

BARNHART AVENUE N.W.

SEC. MAP 246

DATE

PAGE NO N.W.355

2/87 NP