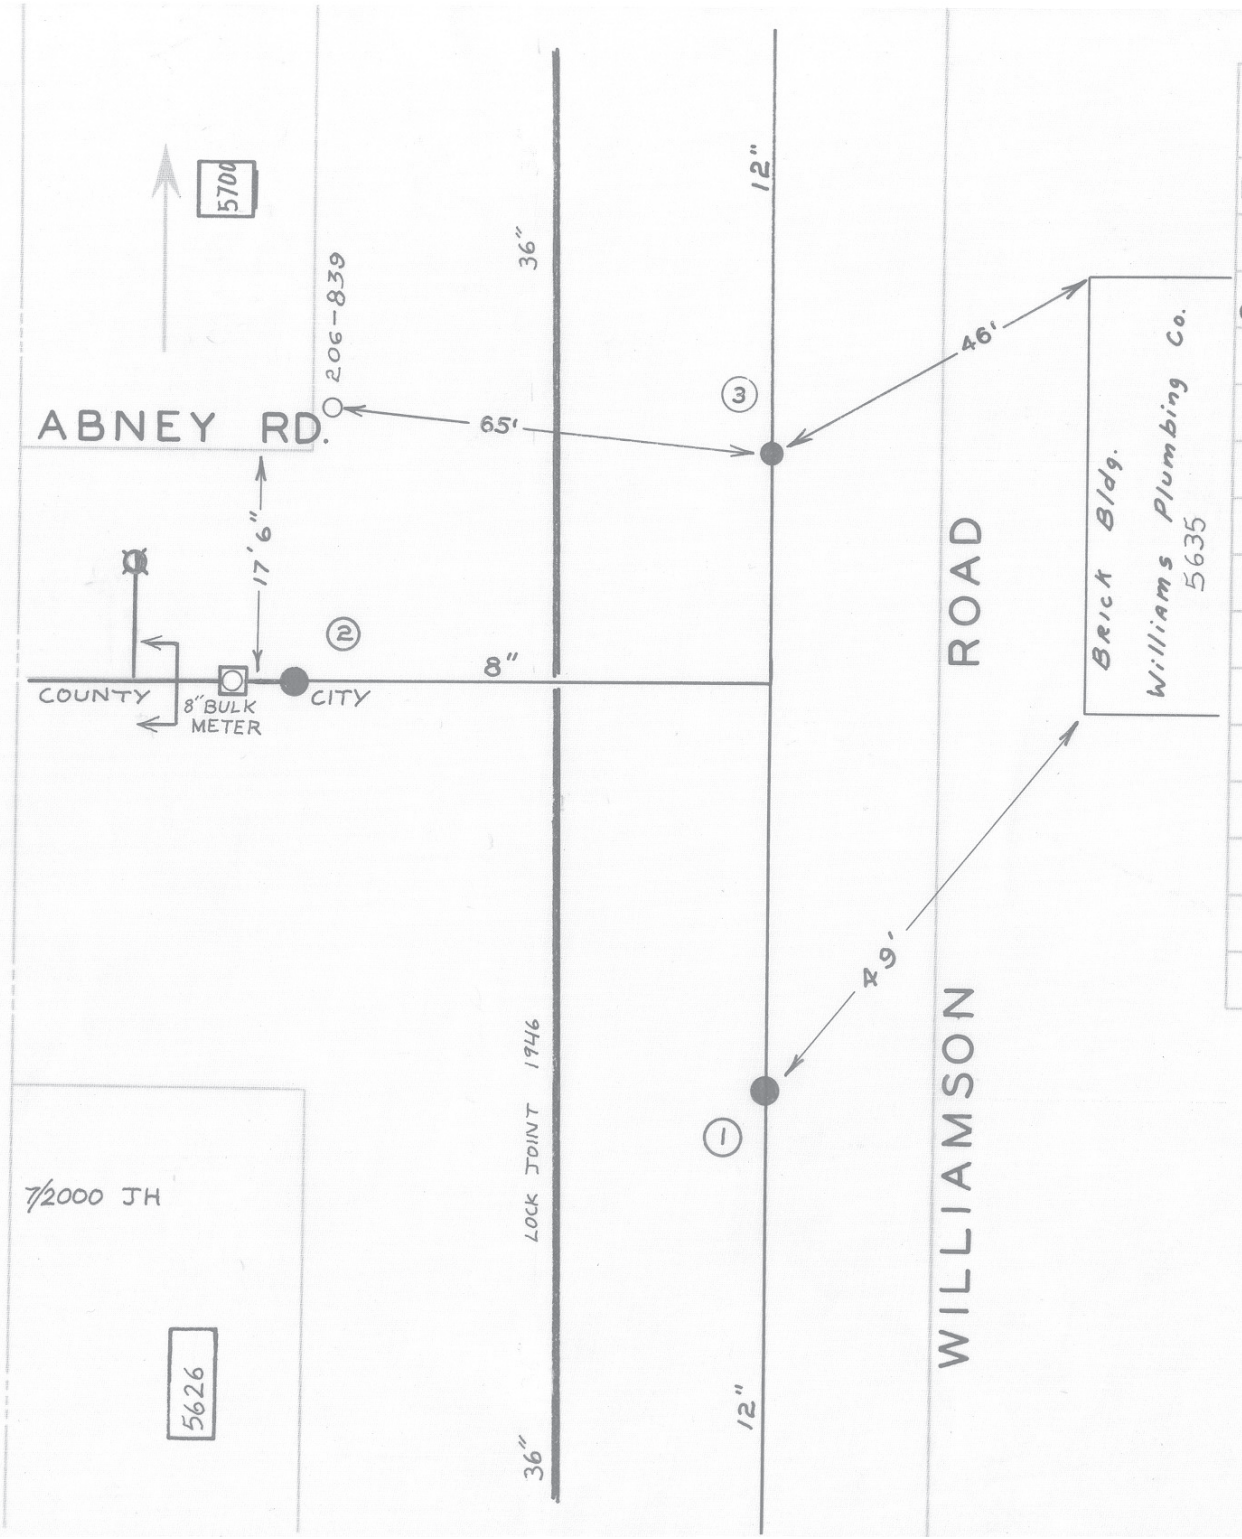

DATE	NO.	SIZE	MAKE	OPEN	TURNS
1957	1	12"	DARLING		
1957	2	8"	DARLING		
6-64	3	12"	MUELLER	R	
	1	0	SPL		
	2	0	WPL		
	3	0	N.P.L.		

CITY OF ROANOKE—WATER DEP'T

VALVE DIAGRAM

ABNEY RD. &

WILLIAMSON RD. N.W.

SEC. MAP 3 COUNTY

DATE PAGE NO.