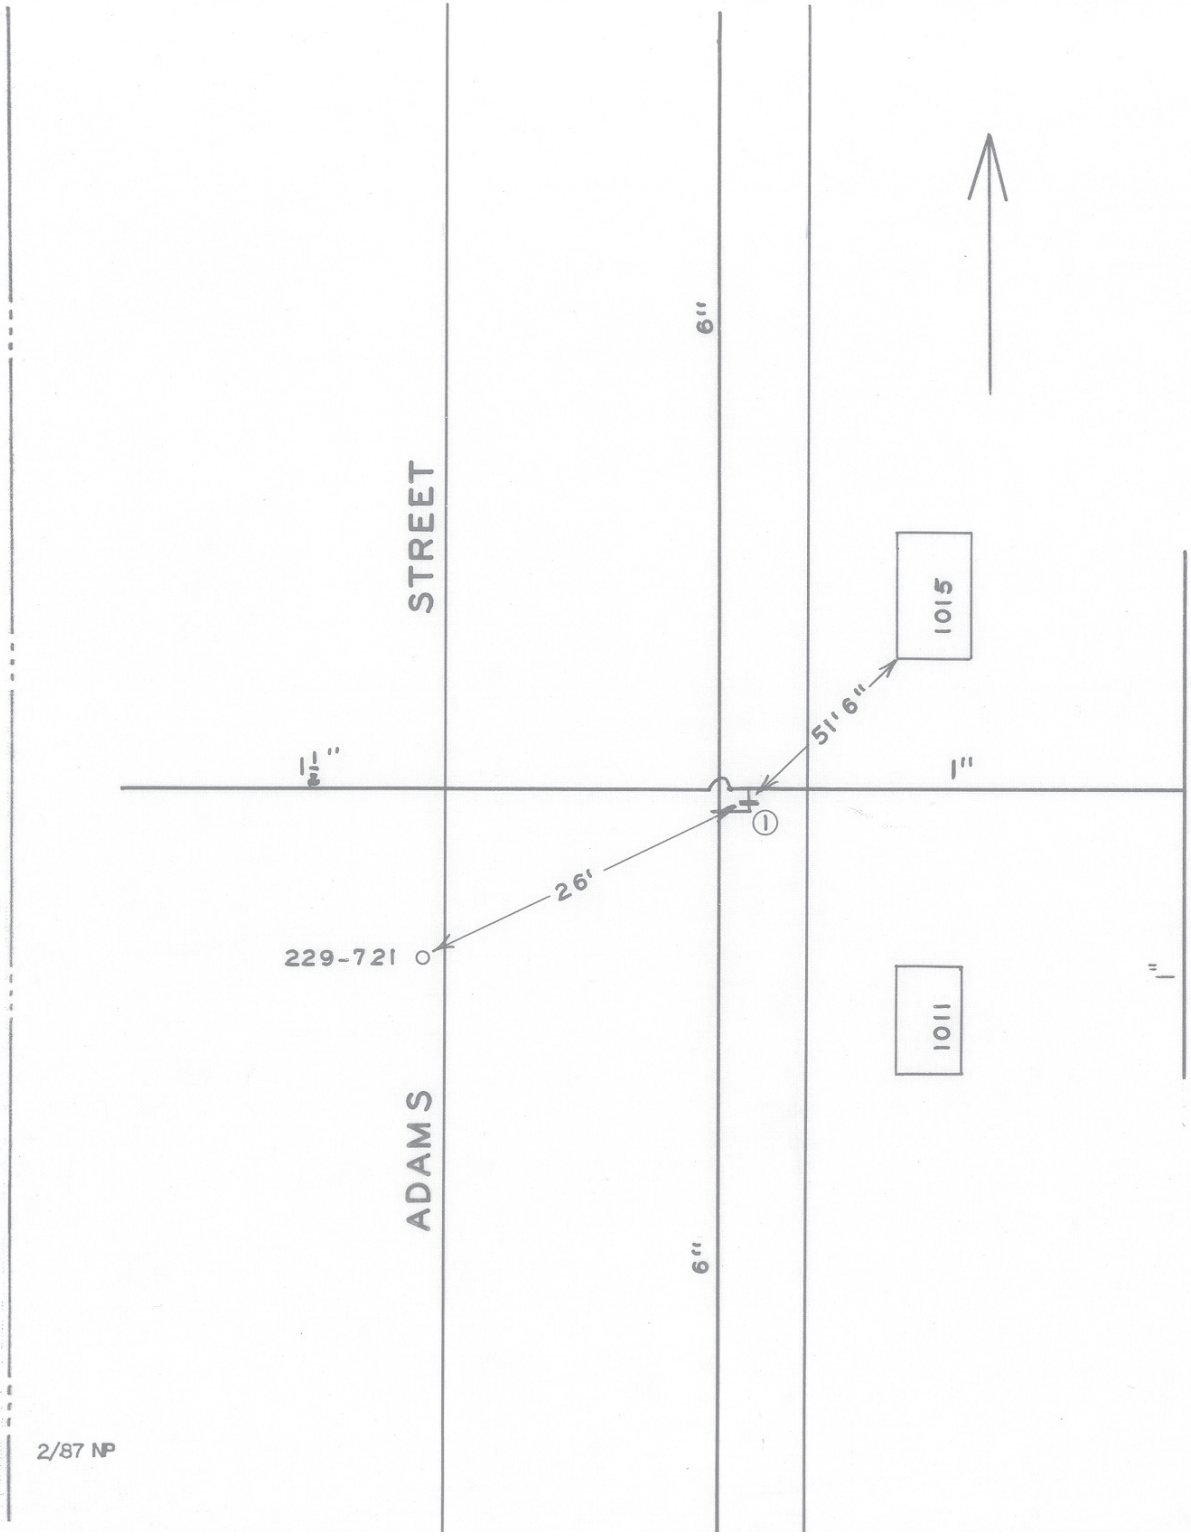

DATE	NO.	SIZE	MAKE	OPEN	TURNS
8-63	1	1"	CURB COCK		

CITY OF ROANOKE — WATER DEPT.

VALVE DIAGRAM

1015 ADAMS STREET N.W.

SEC. MAP 276

DATE PAGE NO.

2/87 NP