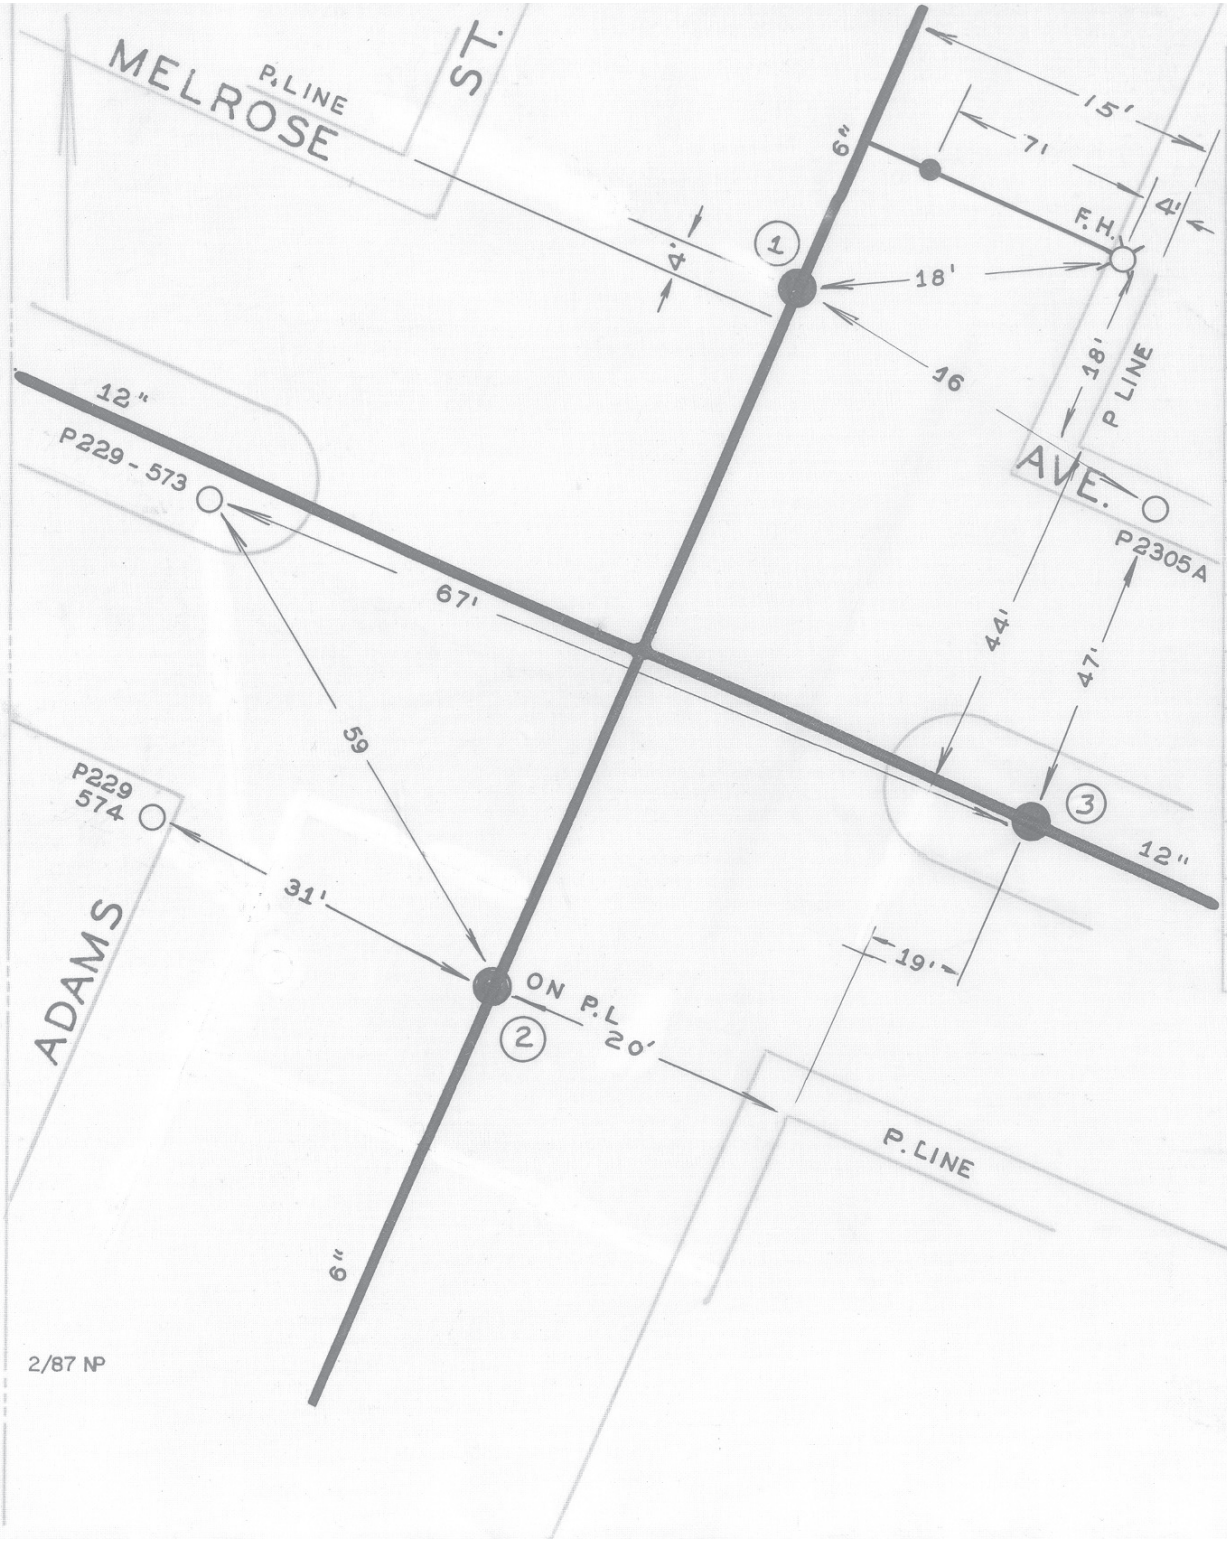

DATE	NO.	SIZE	MAKE	OPEN	TURNS
1950	1	6"	DARLING	R	20
1950	2	6"	DARLING	R	20
1950	3	12"	DARLING	R	39 1/2
	1	4'-N	NPL		
	2	19'-E	EPL		
	3	0	SPL		

CITY OF ROANOKE—WATER DEP'T

VALVE DIAGRAM

ADAMS STREET &

MELROSE AVE. N.W.

SEC. MAP 276

DATE PAGE NO. NW363

2/87 NP