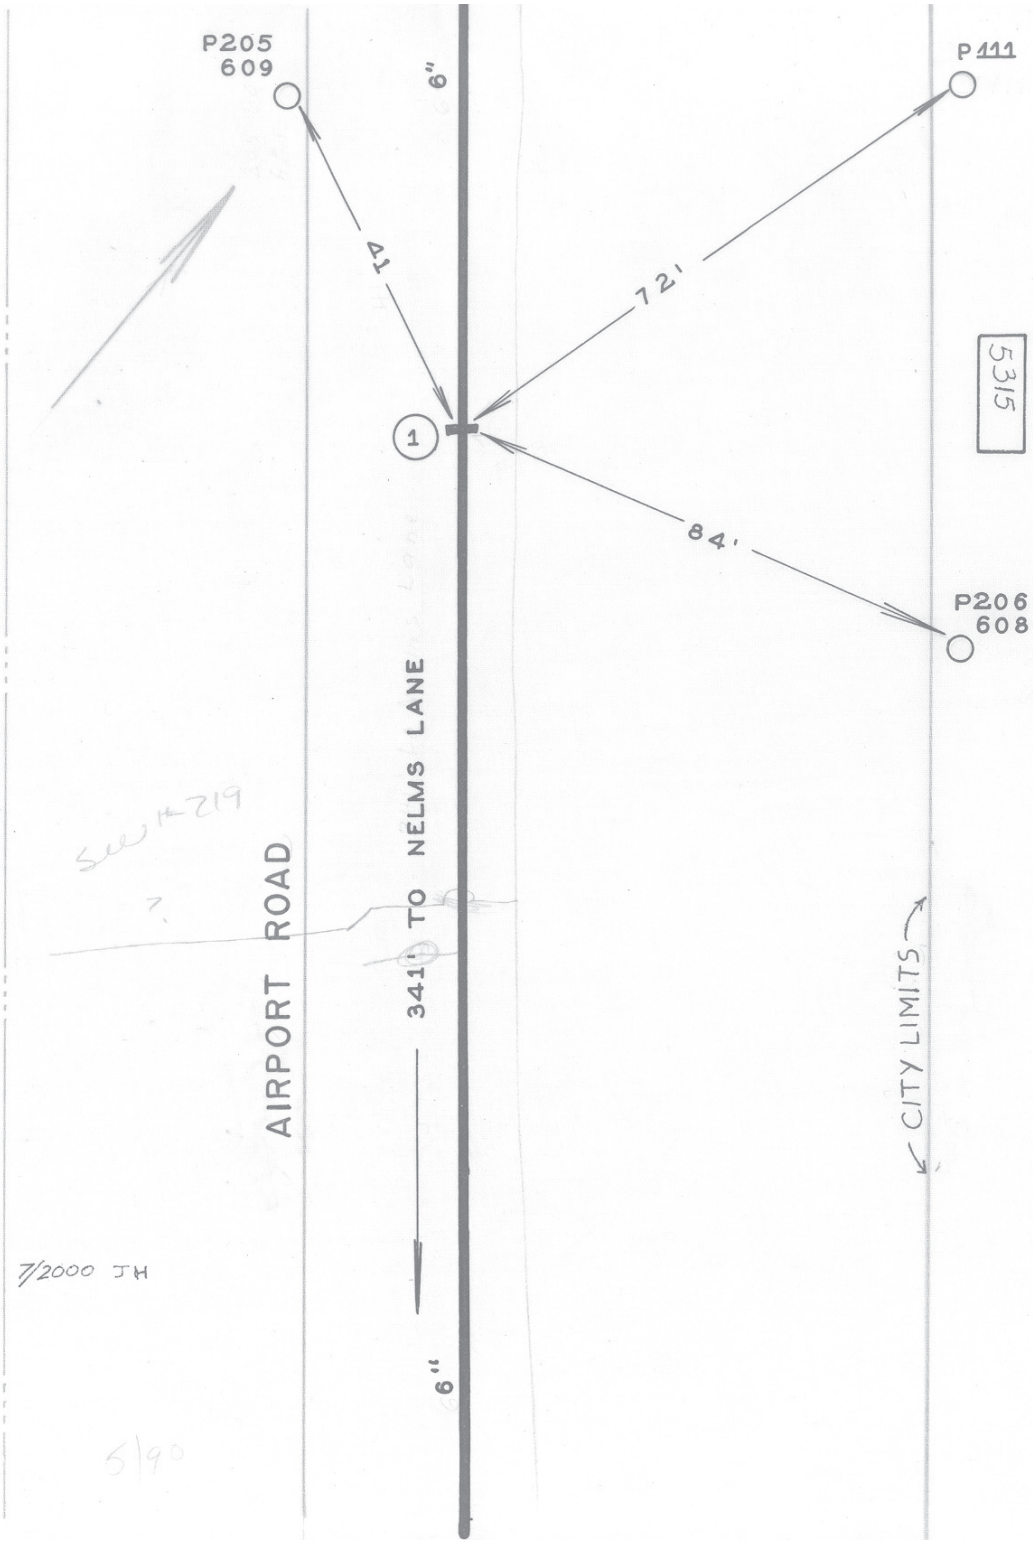

DATE	NO.	SIZE	MAKE	OPEN	TURNS
WR 1951	1	6"			

CITY OF ROANOKE — WATER DEPT.

VALVE DIAGRAM

AIRPORT ROAD,

5300 BLOCK, N. W.

SEC. MAP 219

DATE WR PAGE NO NW455

5300 Blk Block Airport Rd

"IMPERIAL" TRACING CLOTH K & E CO., N. Y.