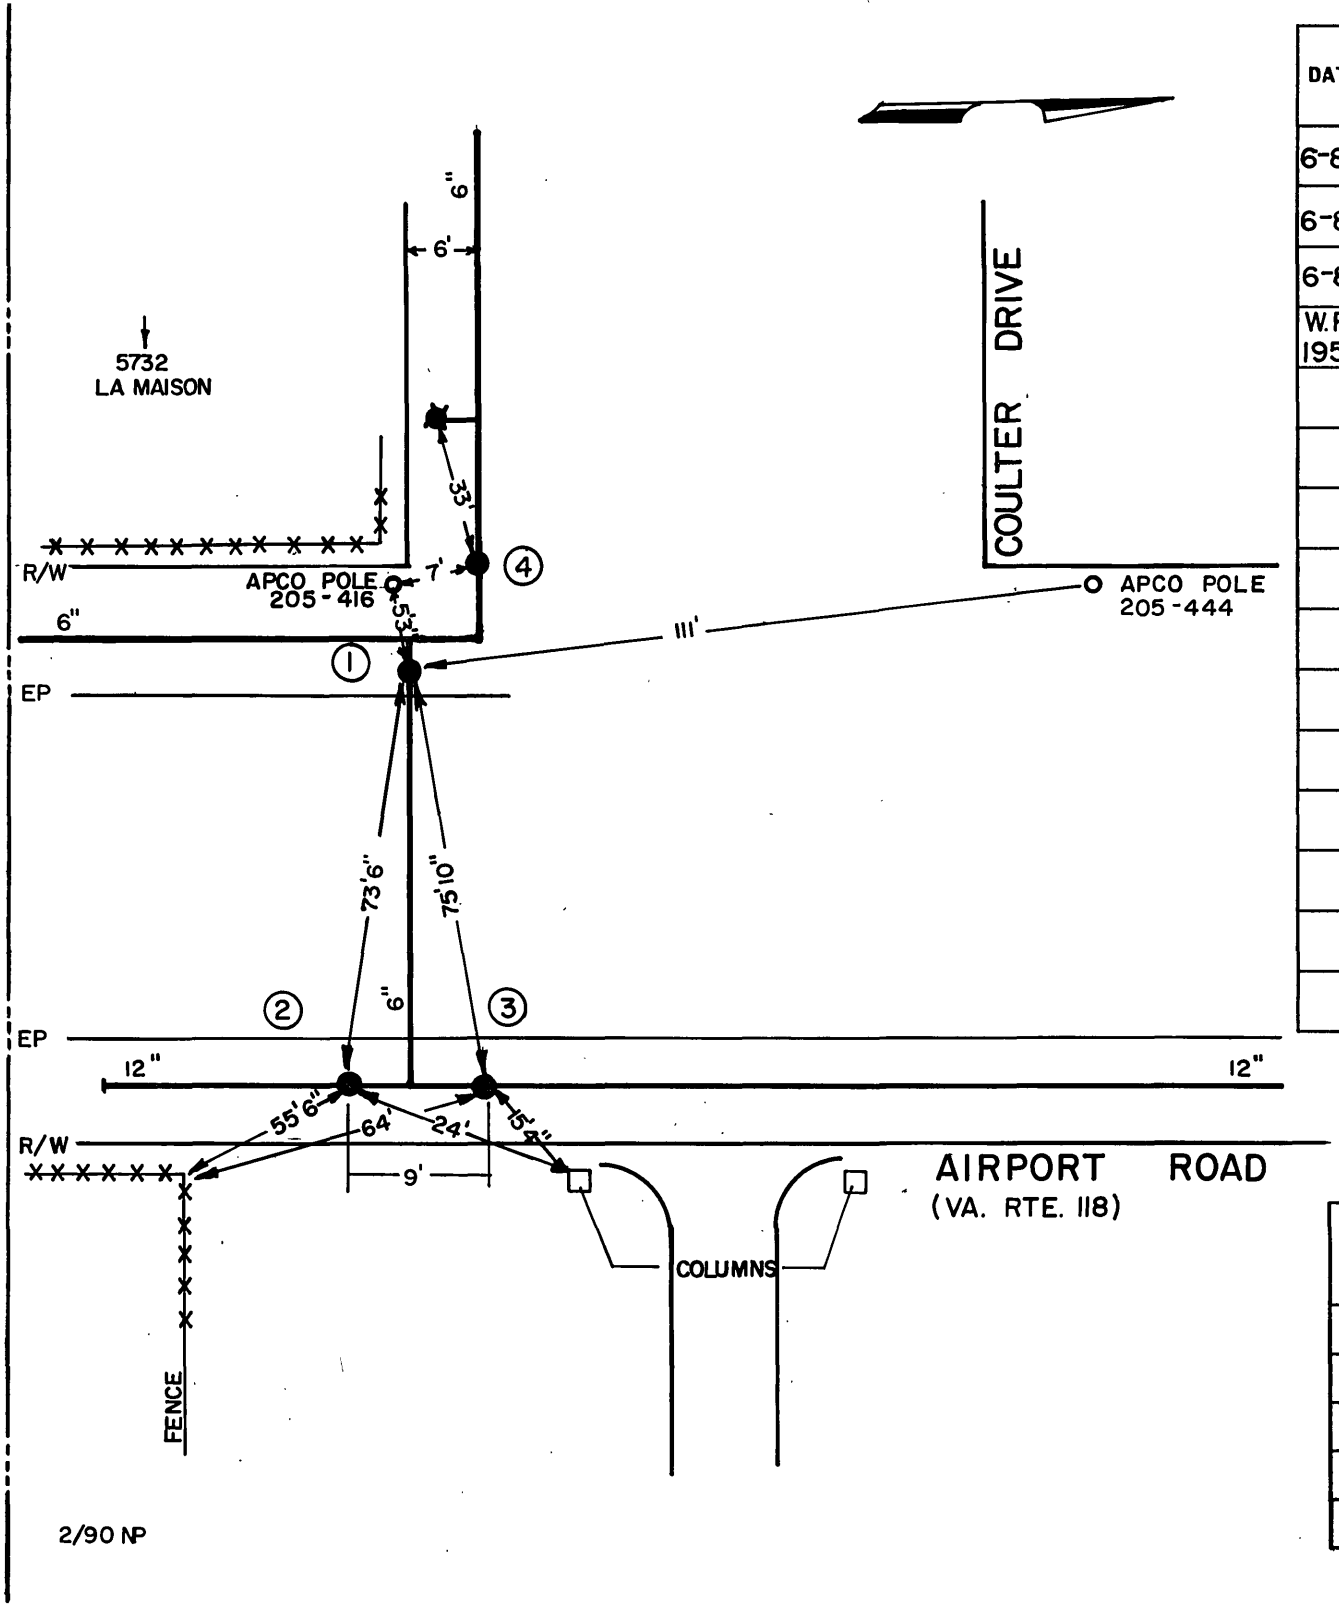

DATE	NO.	SIZE	MAKE	OPEN	TURNS
6-88	1	6"			
6-88	2	12"			
6-88	3	12"			
W.R. 1951	4	6"			

CITY OF ROANOKE—WATER DEP'T

VALVE DIAGRAM

AIRPORT ROAD (VA. RTE. 118)

COULTER DRIVE

N.W.

SEC. MAP 663

DATE PAGE NO.