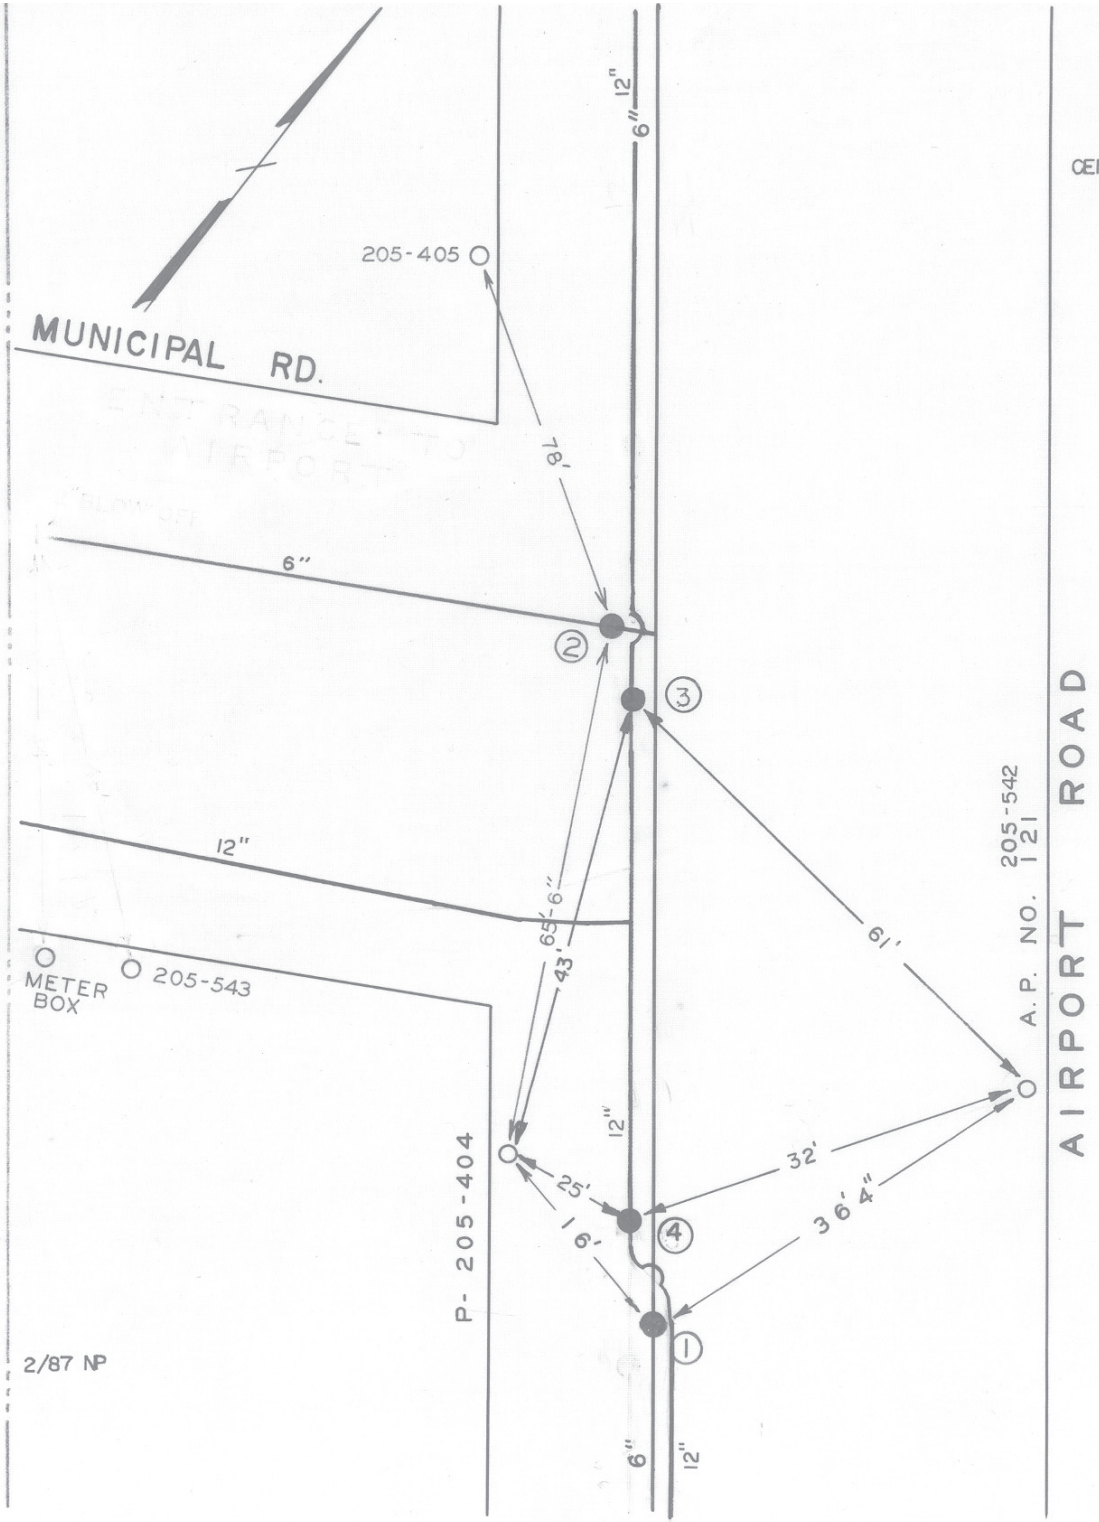

CEMETARY

DATE	NO.	SIZE	MAKE	OPEN	TURNS
W. R. '51	1	6"	MUE.	L	20
4-69	2	6"	MUE.	R	
5-89	3	12"		R	39
5-89	4	12"		R	39

CITY OF ROANOKE—WATER DEPT.

VALVE DIAGRAM

AIRPORT RD. &

MUNICIPAL RD.

N.W.

SEC. MAP 664

DATE PAGE NO.