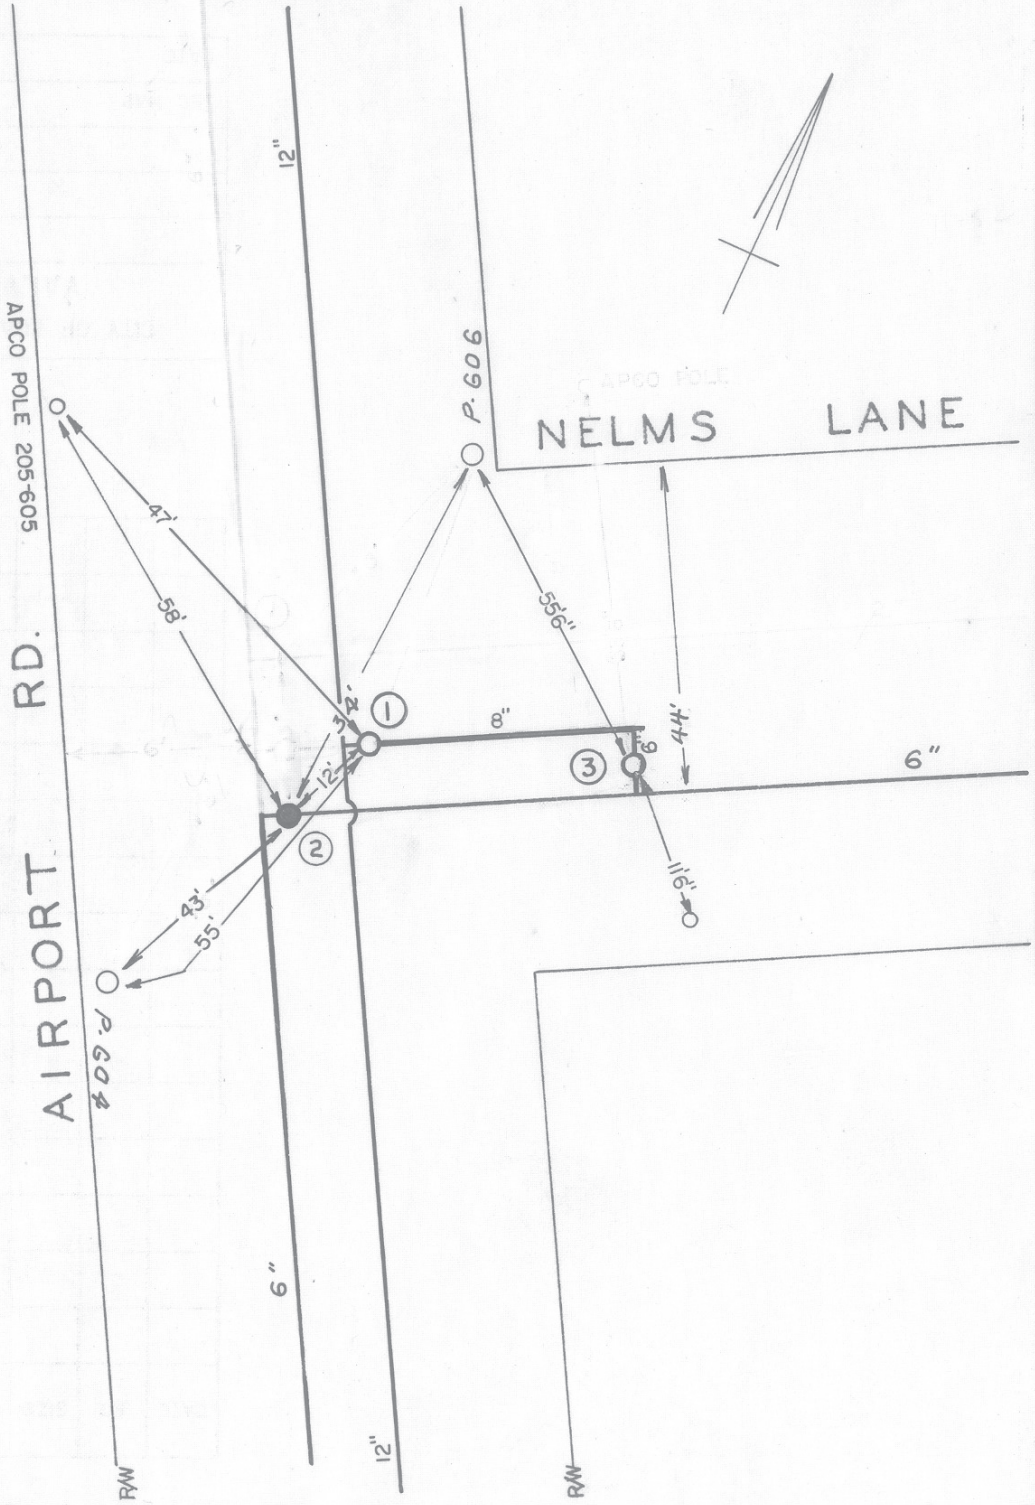

DATE	NO.	SIZE	MAKE	OPEN	TURNS
11-90	1	8"			
11-52	2	6"			
11-90	3	6"			
	1	7-E	WPL		
	2	7-E	WPL		

CITY OF ROANOKE — WATER DEPT.

VALVE DIAGRAM

AIRPORT RD. & NELMS LANE

SEC. MAP 219 N.W.

DATE PAGE NO.

2/87NP
1/2001 JH

"IMPERIAL" TRACING CLOTH
K & E CO., N. Y.