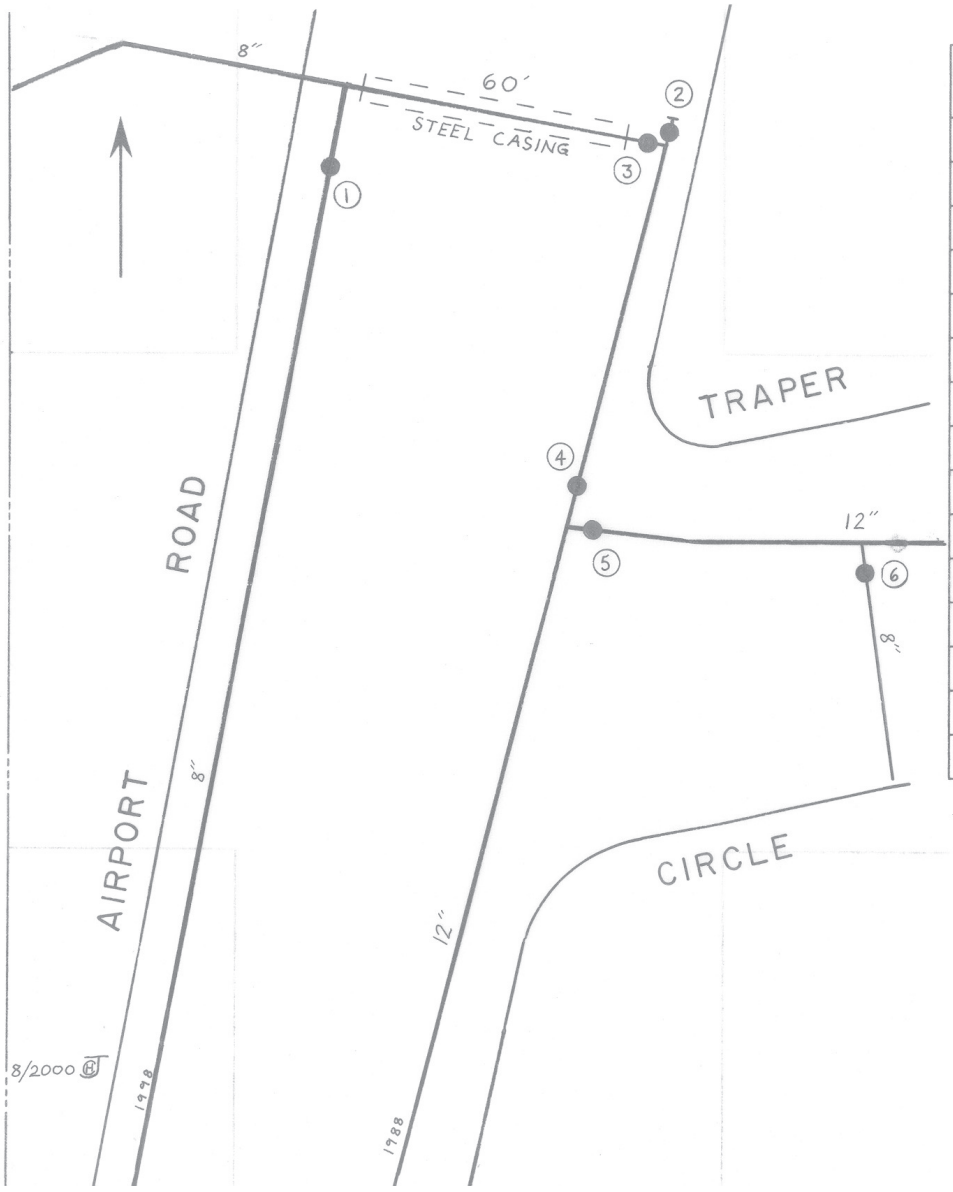

DATE	NO.	SIZE	MAKE	OPEN	TURNS
	1				
	2				
	3				
	4				
	5				
	6				

CITY OF ROANOKE—WATER DEP'T

VALVE DIAGRAM

AIRPORT ROAD

TRAPER CIRCLE

SEC. MAP 662 N. W.

DATE PAGE NO.