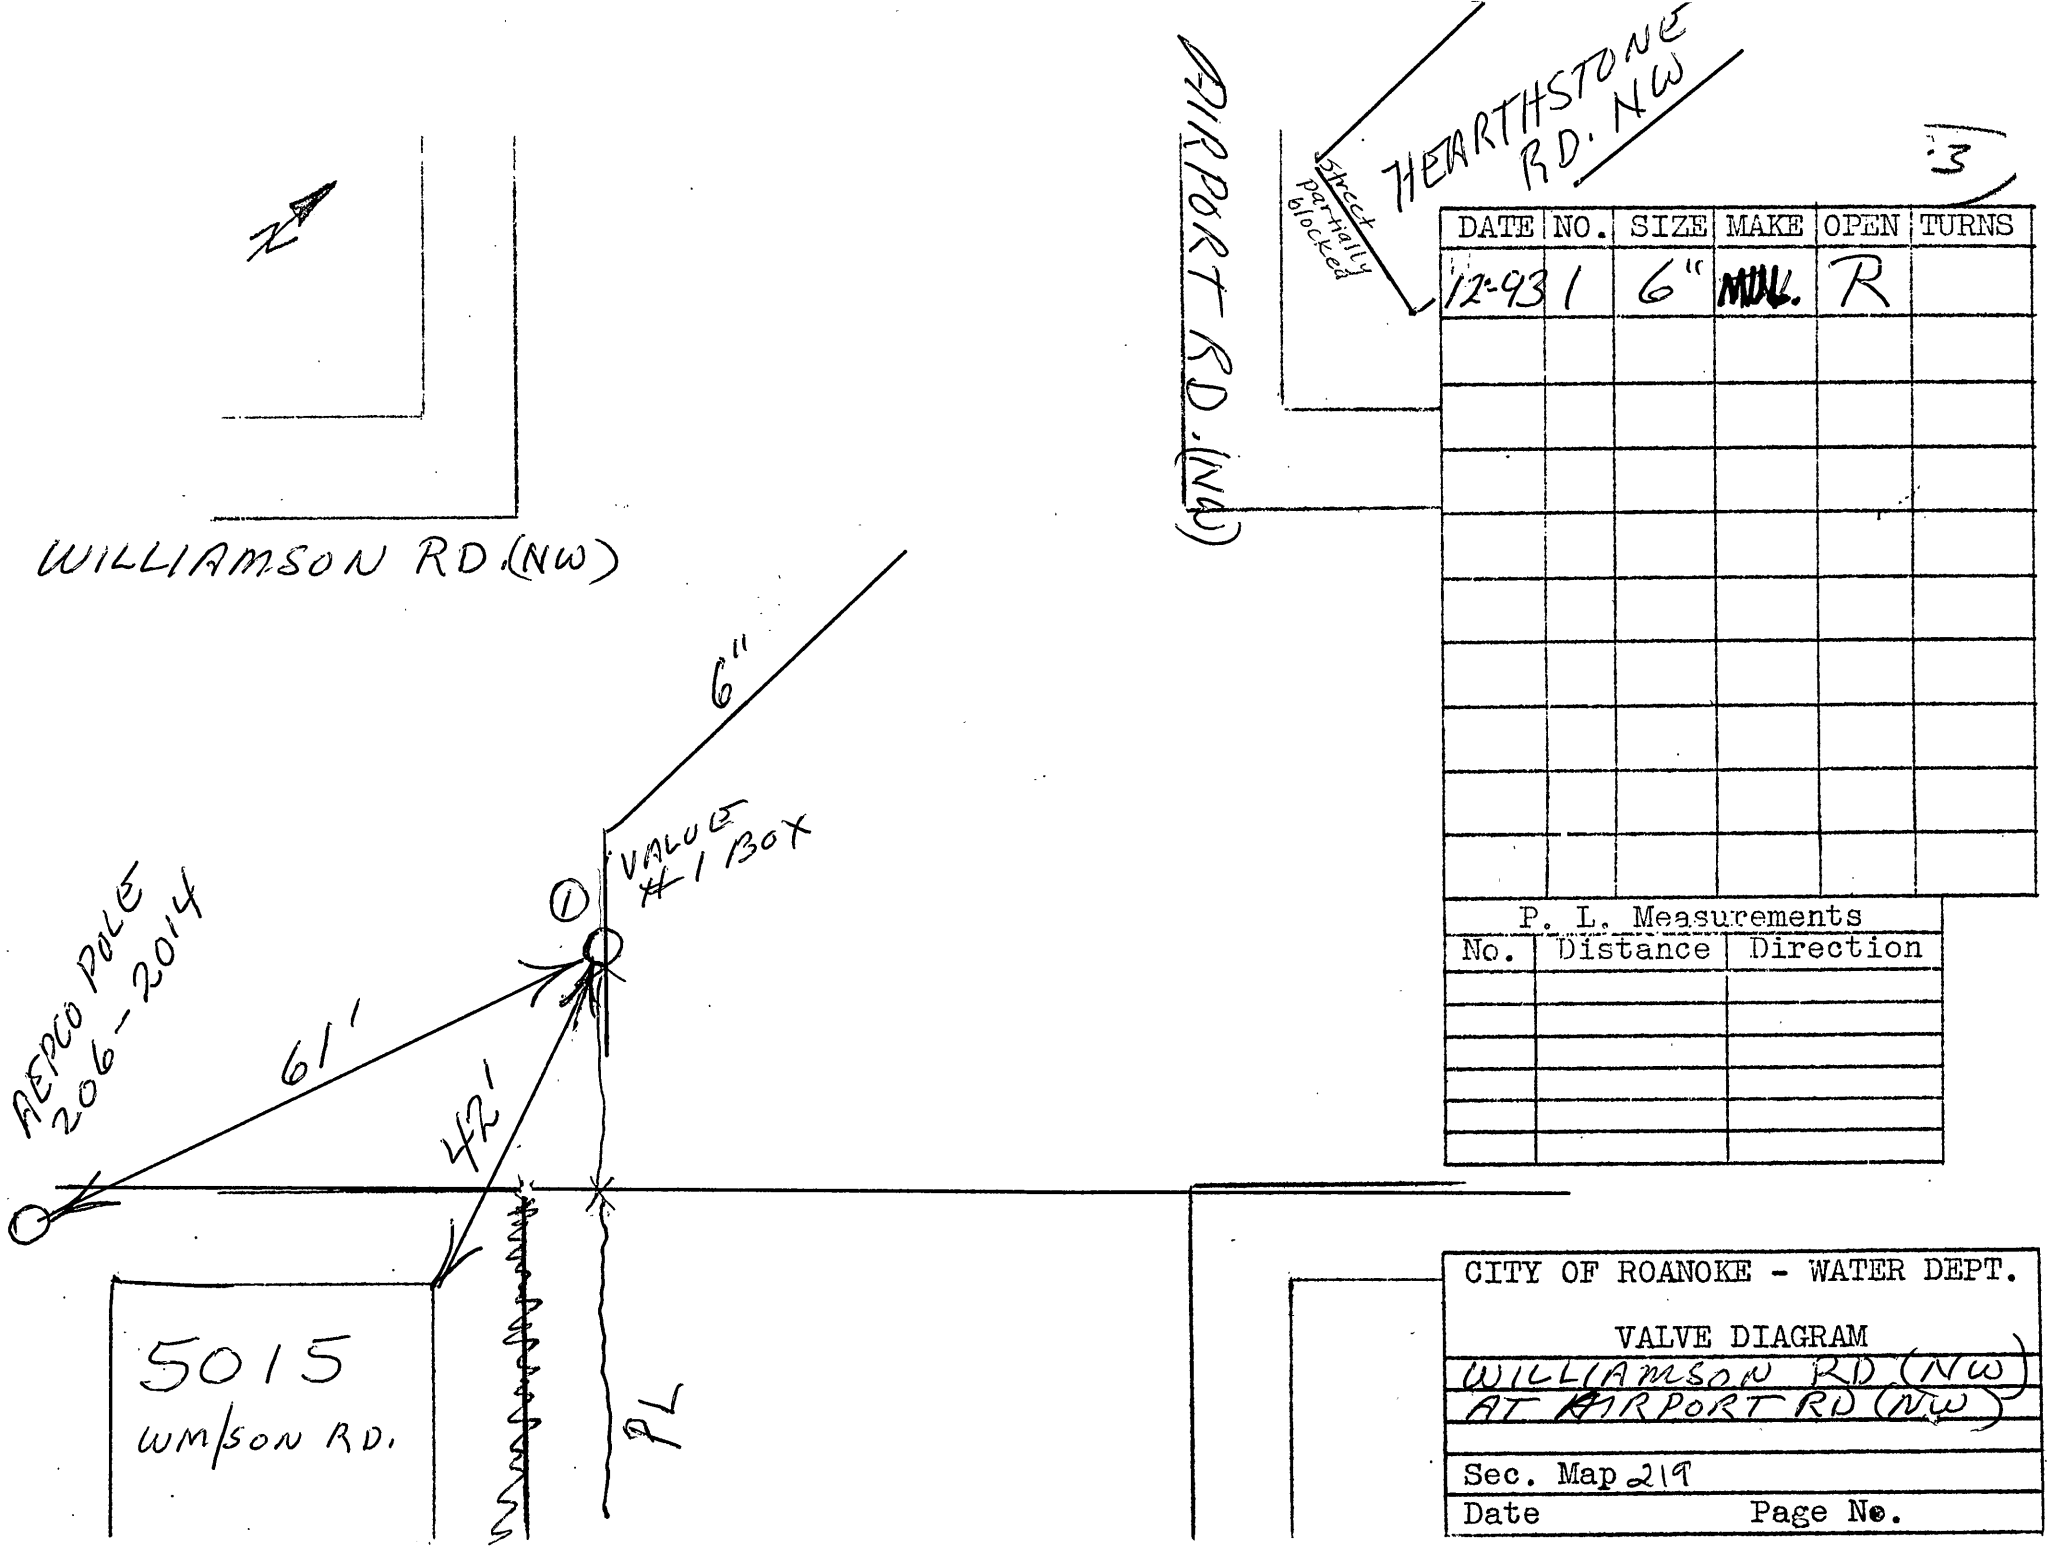

3

DATE	NO.	SIZE	MAKE	OPEN	TURNS
12-93	1	6"	MUL.	R	

P. L. Measurements

No.	Distance	Direction

CITY OF ROANOKE - WATER DEPT.

VALVE DIAGRAM

WILLIAMSON RD (NW)
AT AIRPORT RD (NW)

Sec. Map 219

Date Page No.