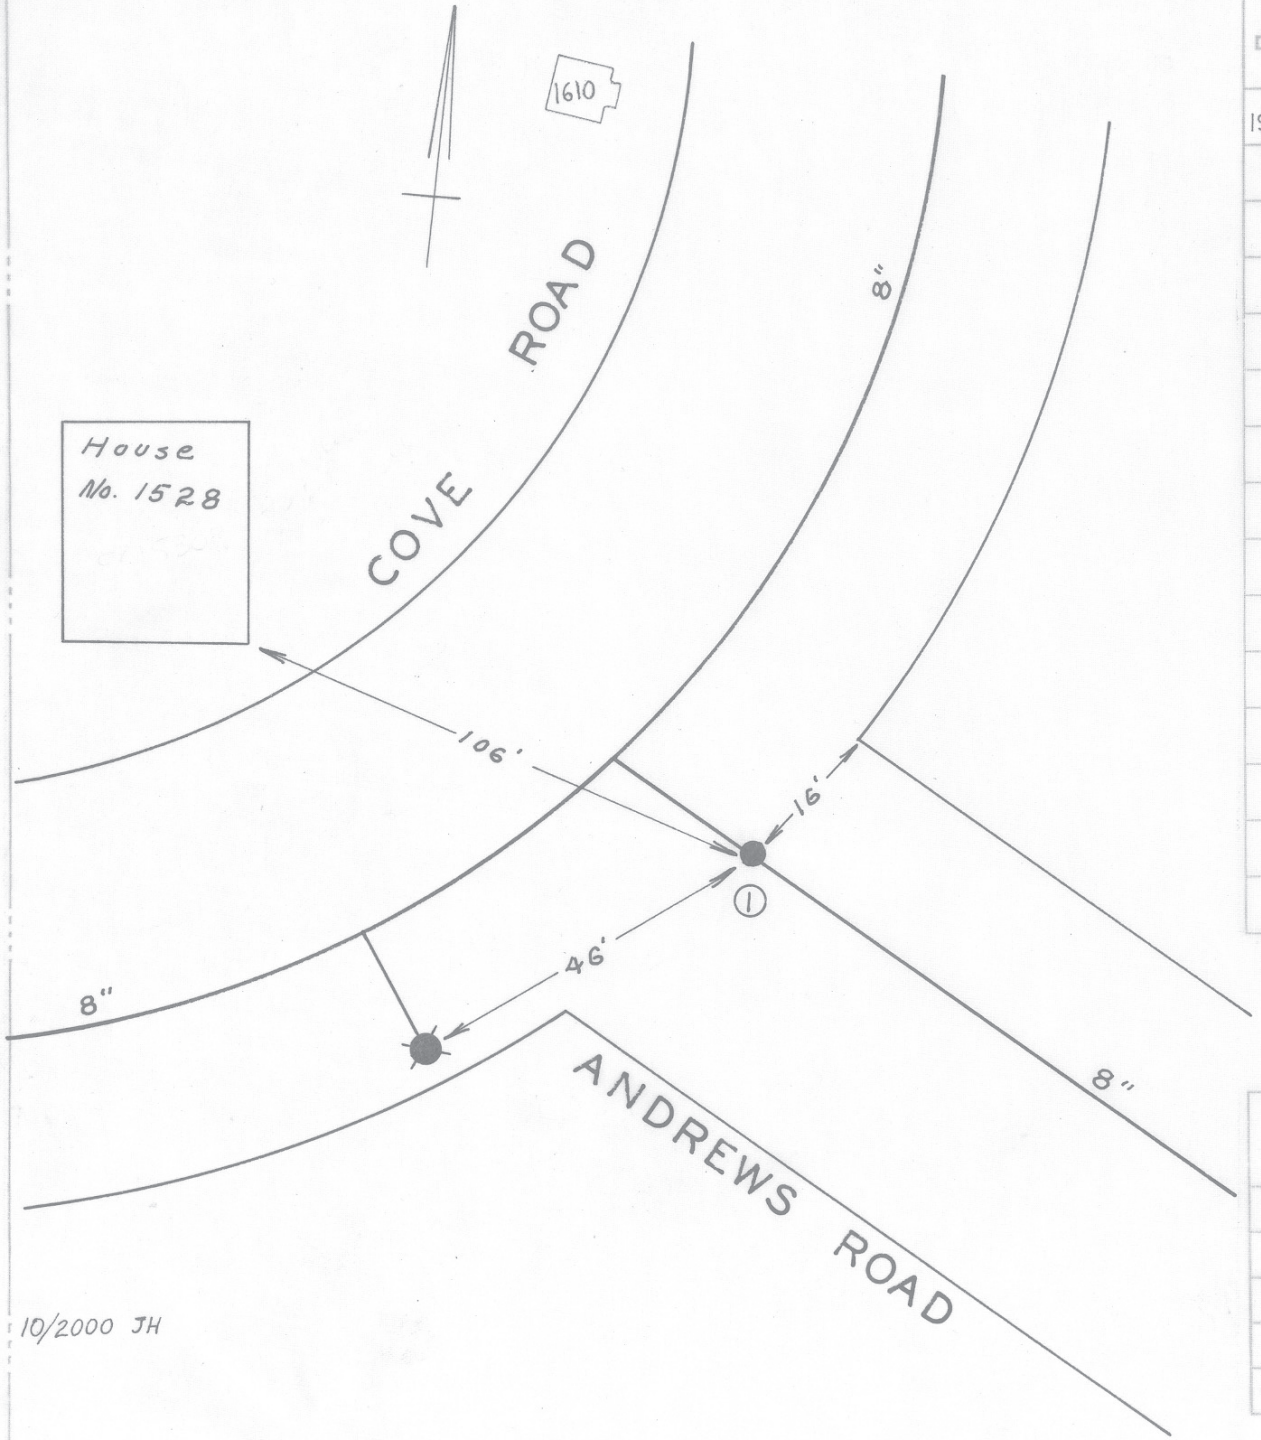

DATE	NO.	SIZE	MAKE	OPEN	TURNS
1956	1	8"	MUELLER	R	27
	1	0	EPL		

CITY OF ROANOKE--WATER DEPT.

VALVE DIAGRAM

ANDREWS RD. & COVE ROAD

SEC. MAP 235, 245 N.W.

DATE PAGE NO.

10/2000 JH

2187

"IMPERIAL" TRACING CLOTH. K & E CO., N. Y.