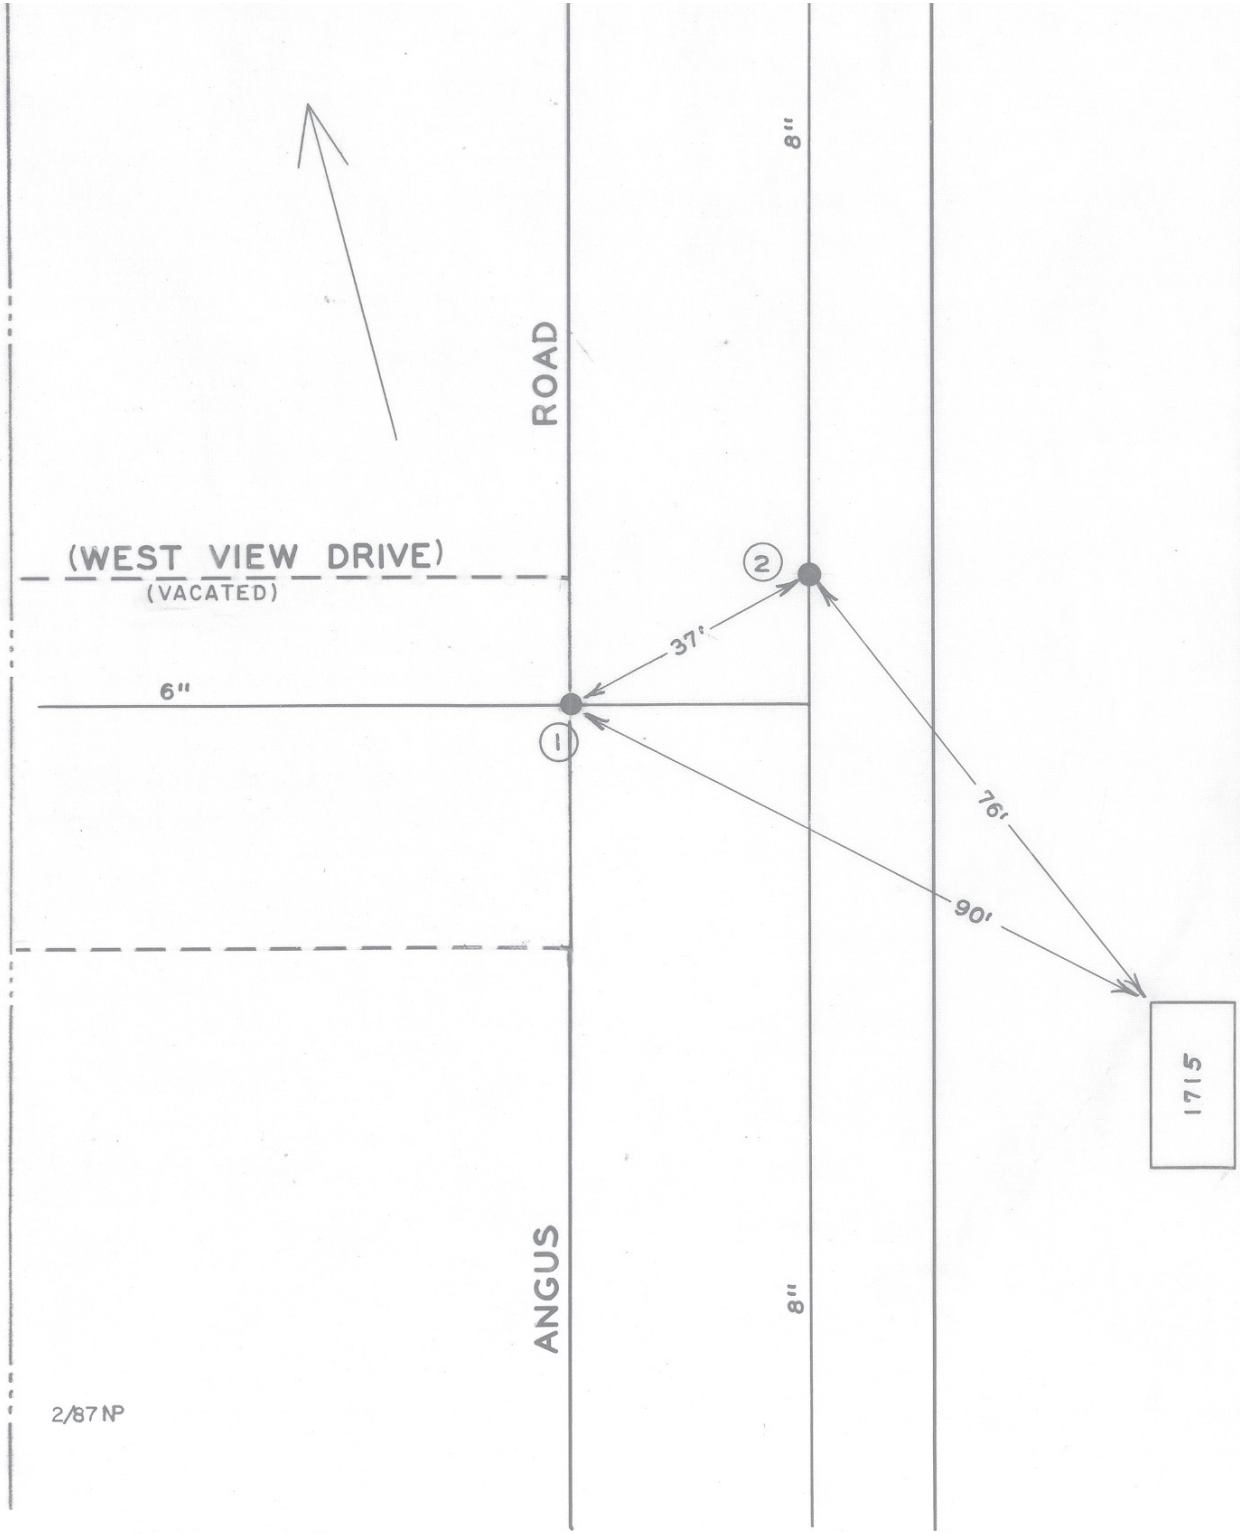

DATE	NO.	SIZE	MAKE	OPEN	TURNS
4-62	1	8"	MUELLER	R	27
4-62	2	6"	DARLING	R	21
	1	0	W.P.L.		
	2	0	N.P.L.		

CITY OF ROANOKE — WATER DEPT.

VALVE DIAGRAM

ANGUS ROAD & WEST VIEW DRIVE N.W.

1700 BLOCK

SEC. MAP 638

DATE PAGE NO.