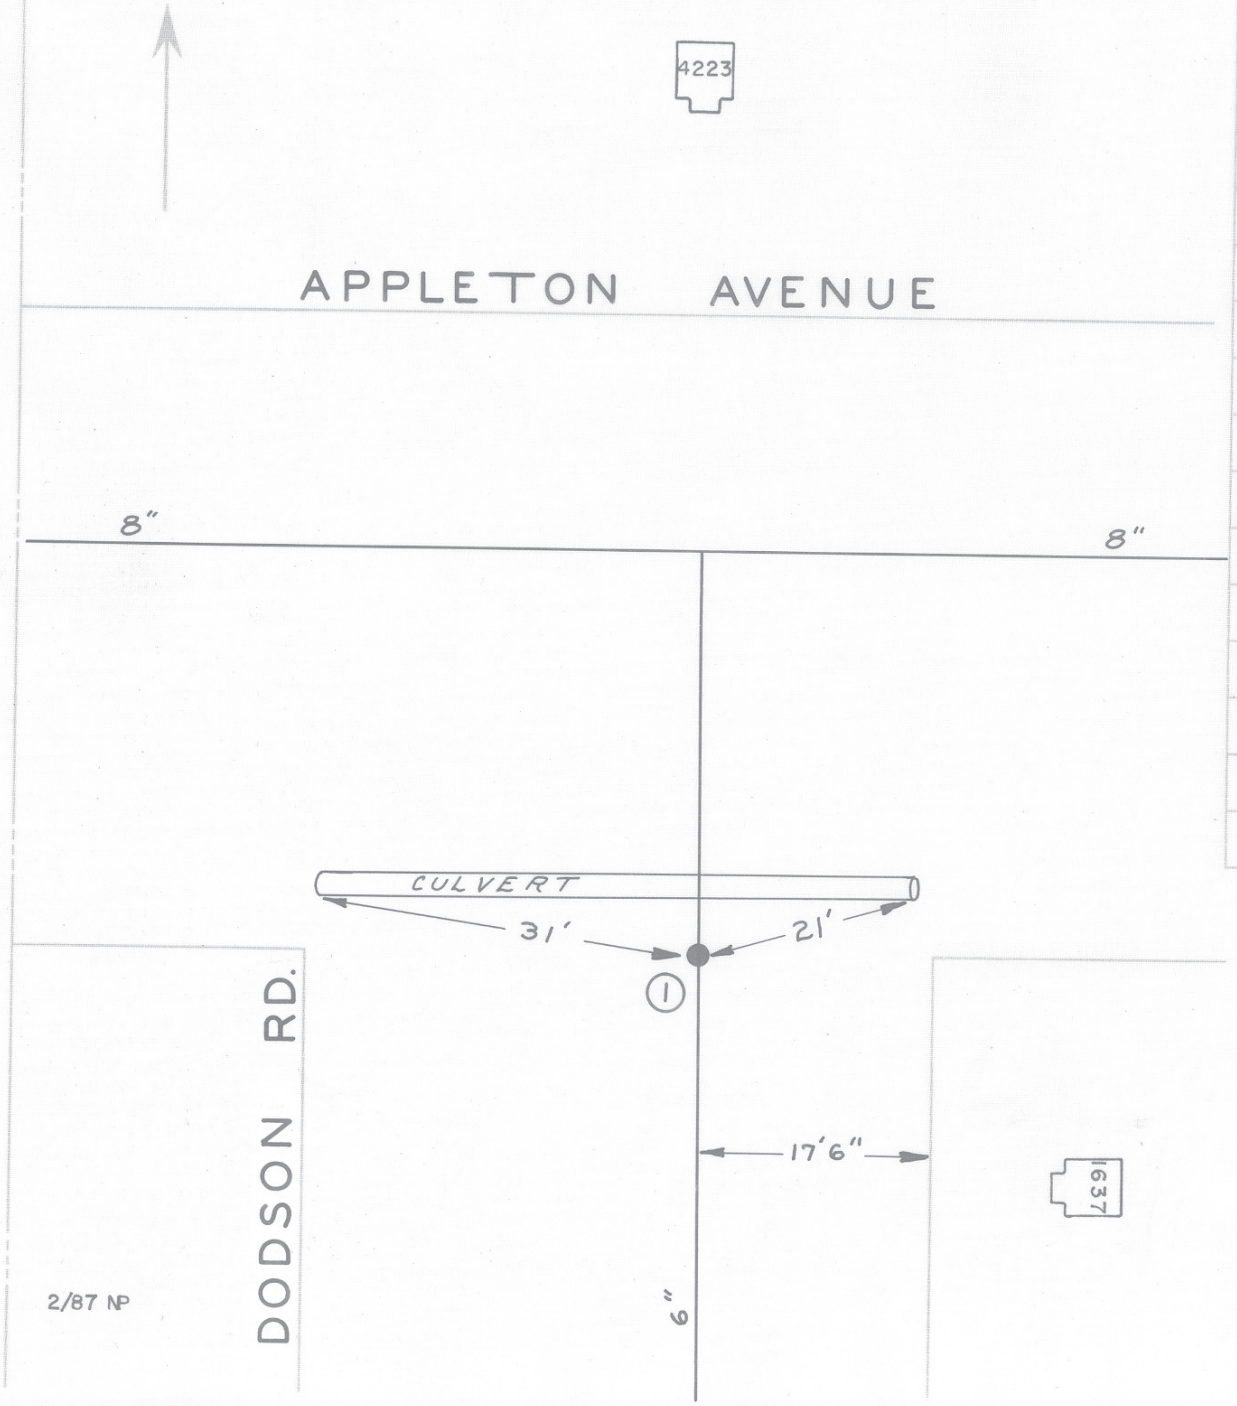

DATE	NO.	SIZE	MAKE	OPEN	TURNS
58	1	6"	MUELLER		
	1	0	SPL		

CITY OF ROANOKE — WATER DEP'T

VALVE DIAGRAM

APPLETON AVE. &

DODSON ROAD N.W.

SEC. MAP 638

DATE PAGE NO.