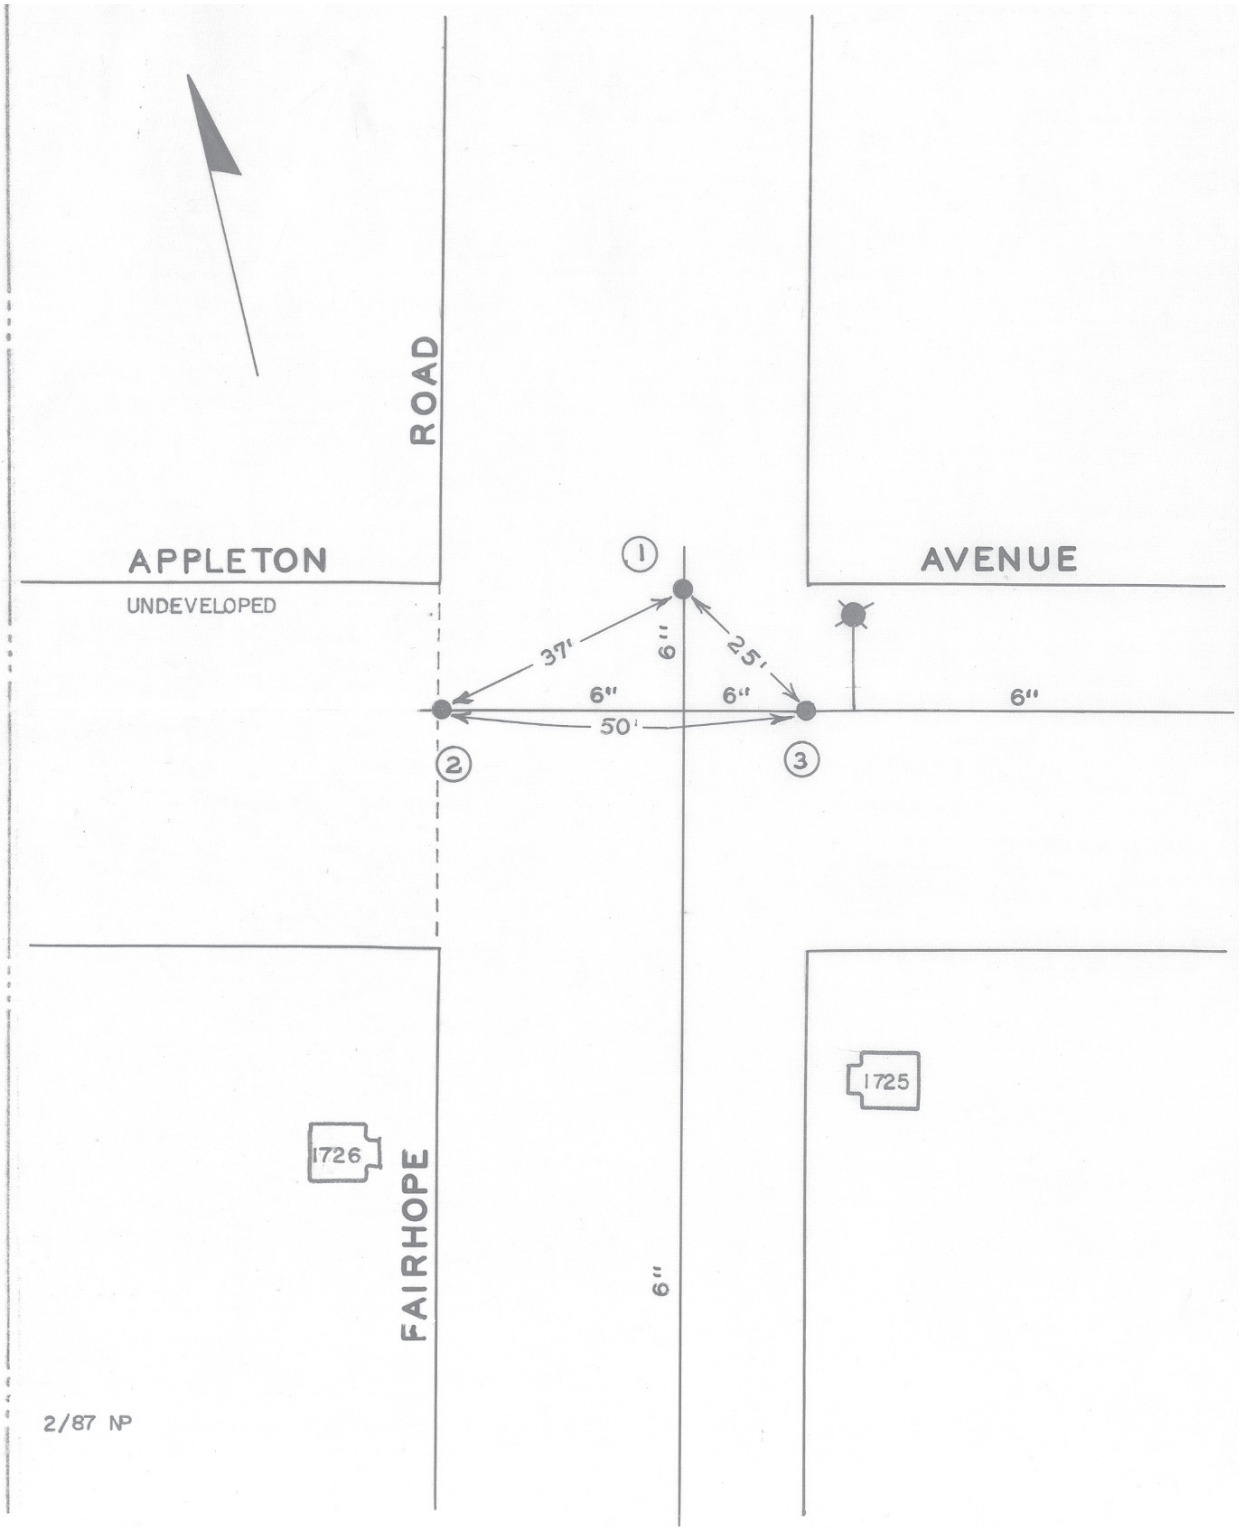

DATE	NO.	SIZE	MAKE	OPEN	TURNS
3-62	1	6"	MUELLER	R	20
3-62	2	6"	MUELLER	R	20
3-62	3	6"	MUELLER	R	20
	1	0	NPL		
	2	0	WPL		
	3	0	EPL		

CITY OF ROANOKE—WATER DEPT.

VALVE DIAGRAM

APPLETON AVENUE &

FAIRHOPE ROAD N.W.

SEC. MAP 639

DATE PAGE NO.