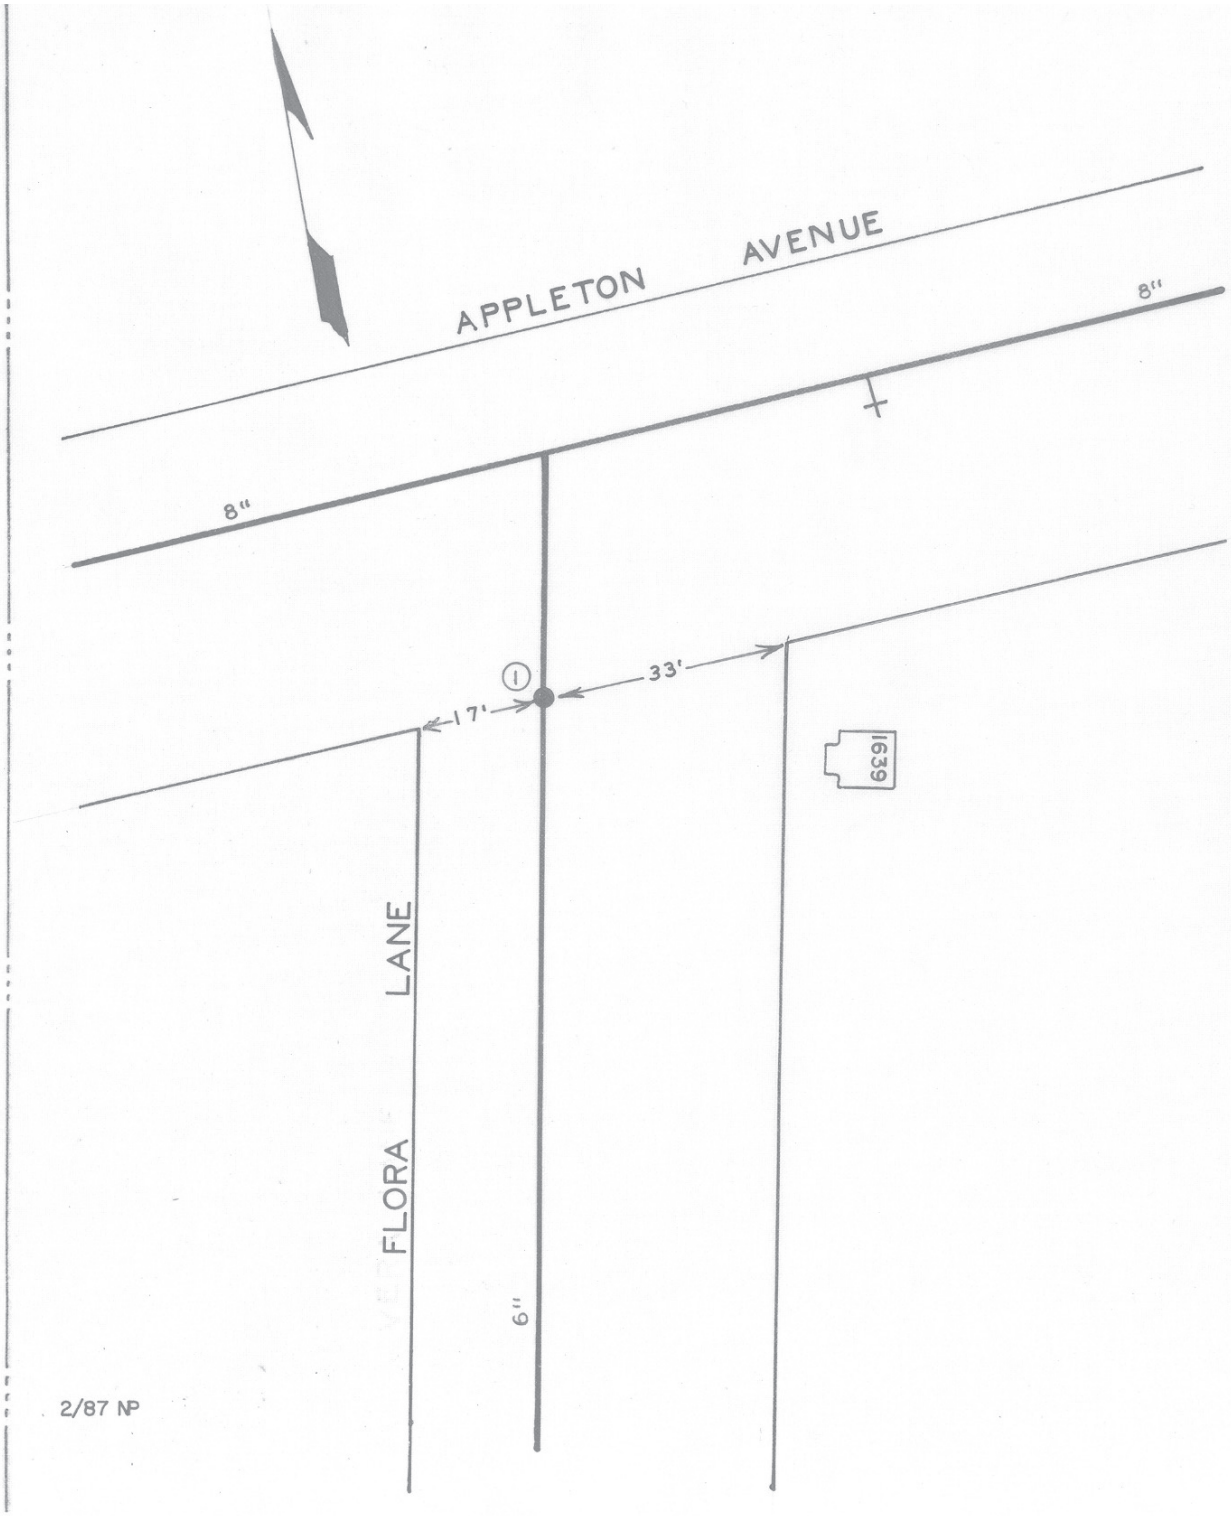

DATE	NO.	SIZE	MAKE	OPEN	TURNS
7-67	1	6"	MUELLER	R	21
	1	0	S.P.L.		

CITY OF ROANOKE—WATER DEPT.

VALVE DIAGRAM

APPLETON AVENUE &

FLORA LANE N.W.

SEC. MAP 638

DATE **PAGE NO.**

2/87 NP