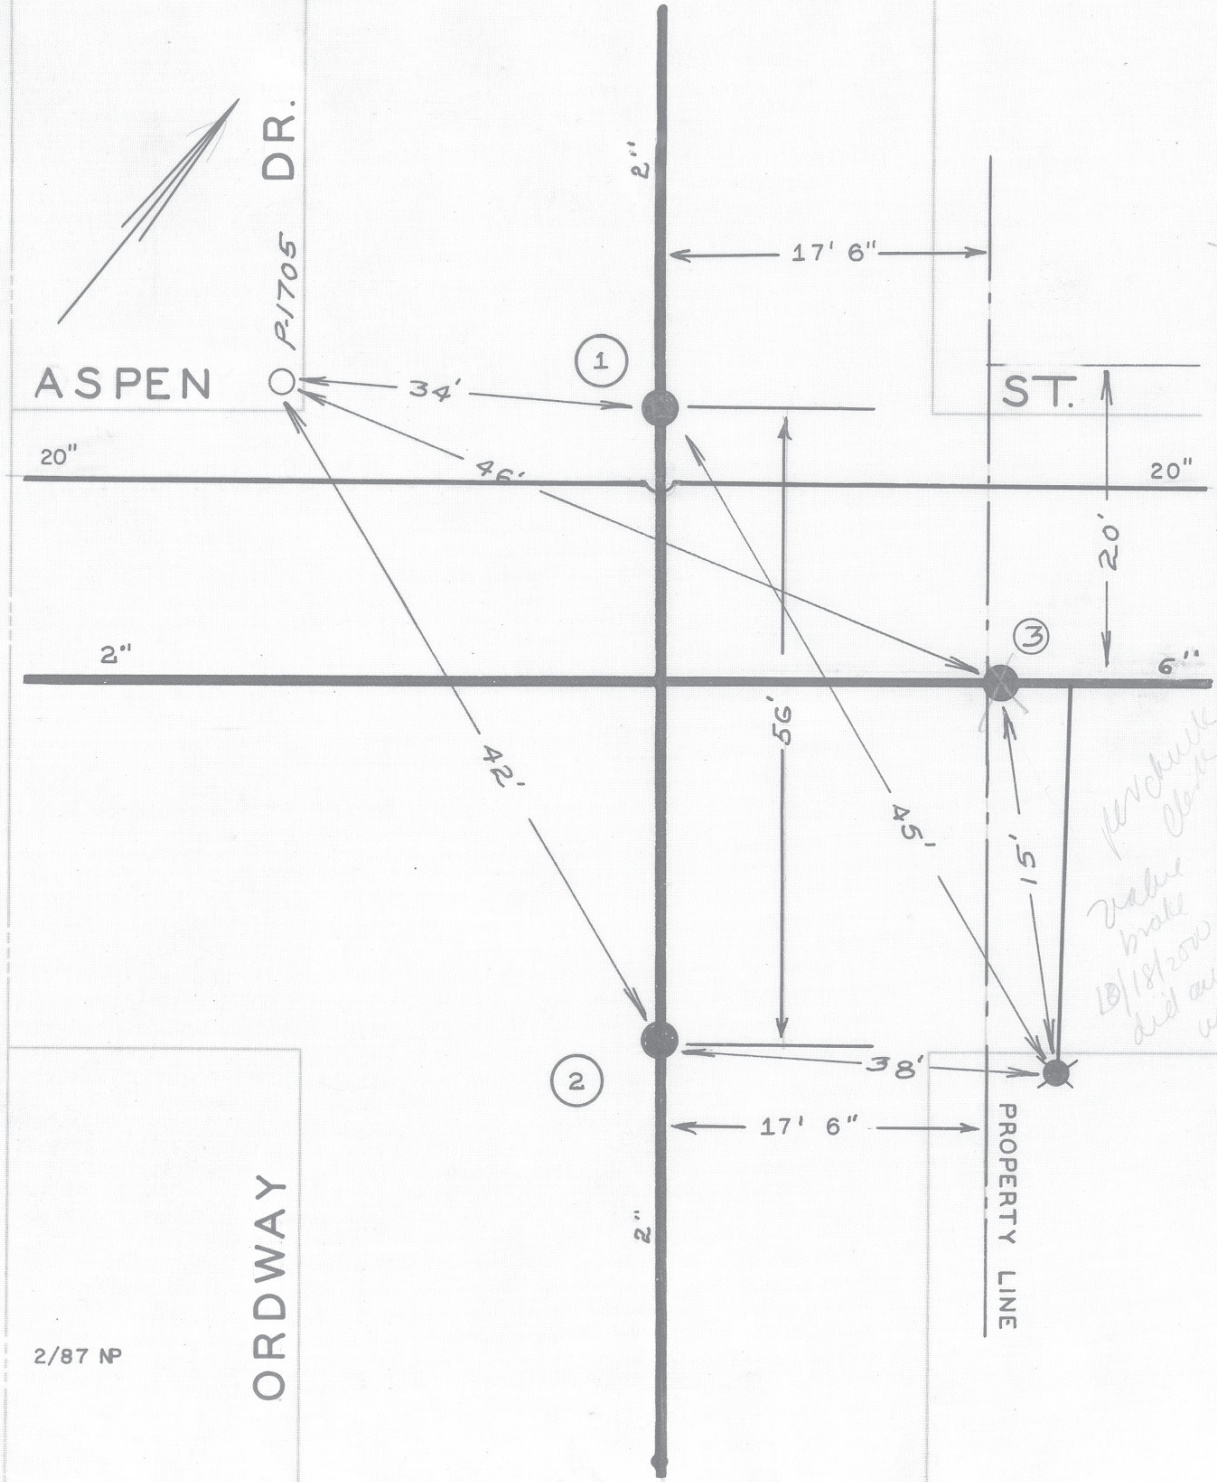

DATE	NO.	SIZE	MAKE	OPEN	TURNS
1947	1	2"	DARLING	R	7
1947	2	2"	DARLING	R	7
1952	3	2"	DARLING	R	7
	1	0	NPL		
	2	0	SPL		
	3	0	EPL		

Hydrant Valve broke 10/18/2010 dug away w/ valve tied the main together

CITY OF ROANOKE—WATER DEP'T

VALVE DIAGRAM

ASPEN ROAD &

ORDWAY DRIVE N.W.

SEC. MAP 247

DATE 5/8/47 PAGE NO. NW 288

2/87 NP