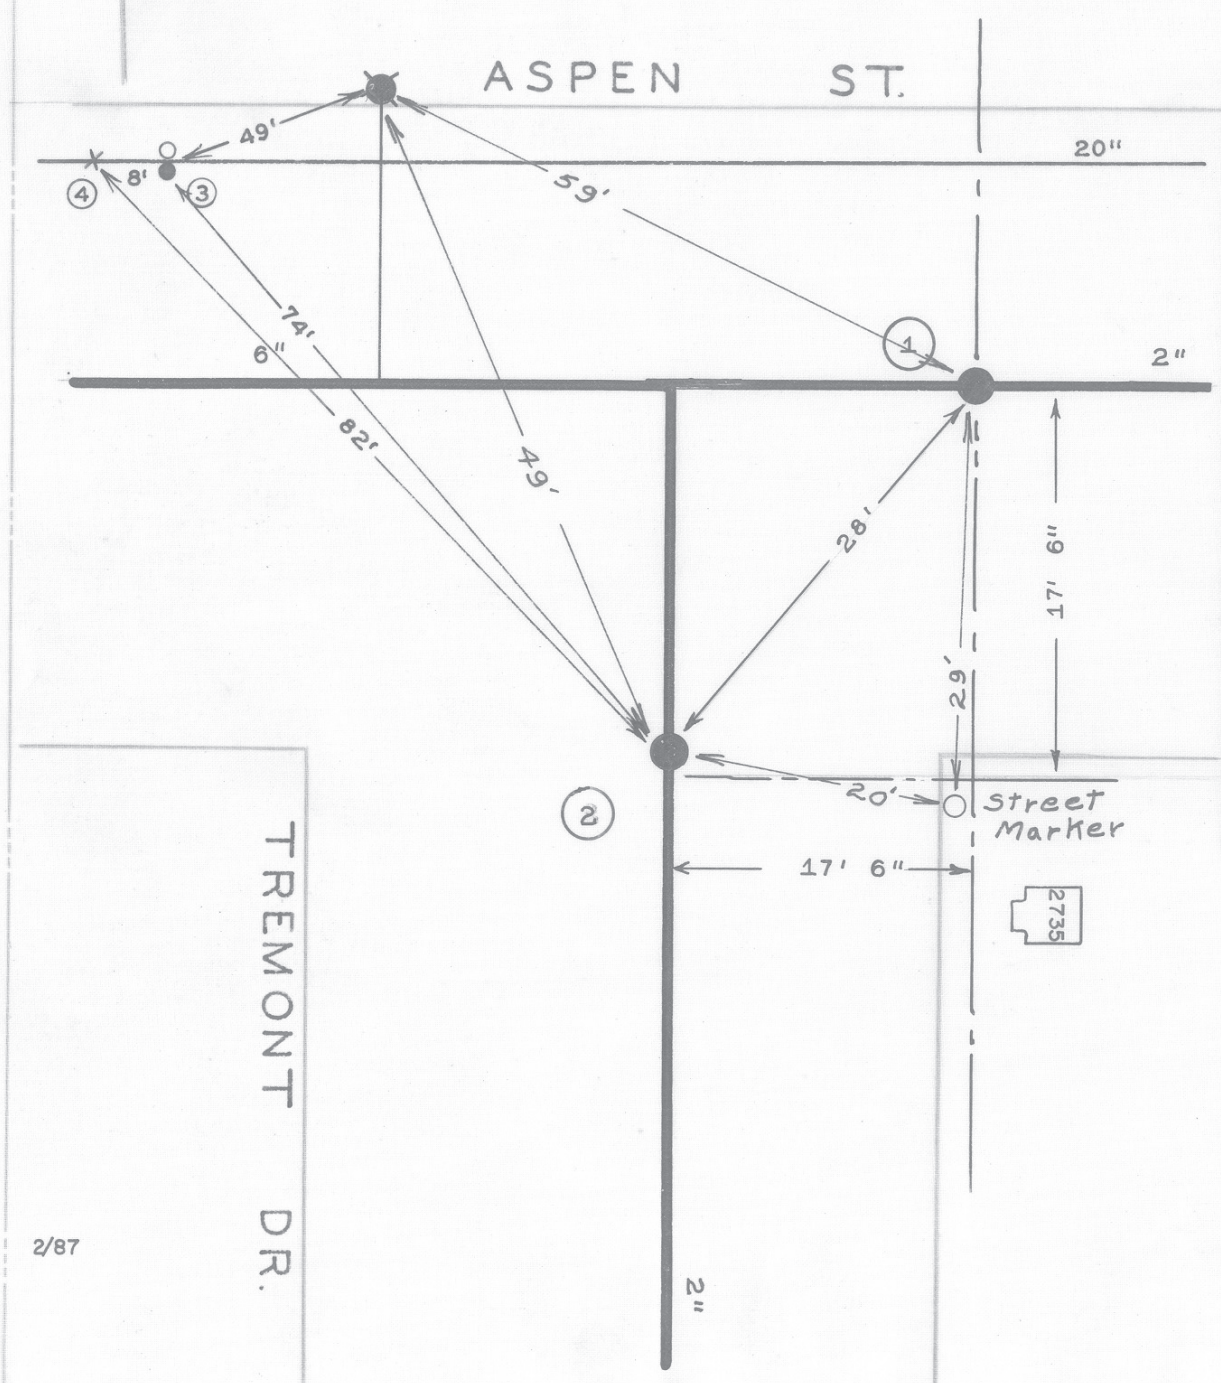

DATE	NO.	SIZE	MAKE	OPEN	TURNS
1947	1	2"	DARLING	R	7
1947	2	2"	DARLING	R	7
12-64	3	20"	DARLING	R	63
12-64	4	1½"	AIR VALVE		
	1	0	EPL		
	2	0	SPL		

CITY OF ROANOKE—WATER DEP'T

VALVE DIAGRAM

ASPEN ROAD &

TREMONT DRIVE N. W.

SEC. MAP 247

DATE PAGE NO. N.W. 290

2/87