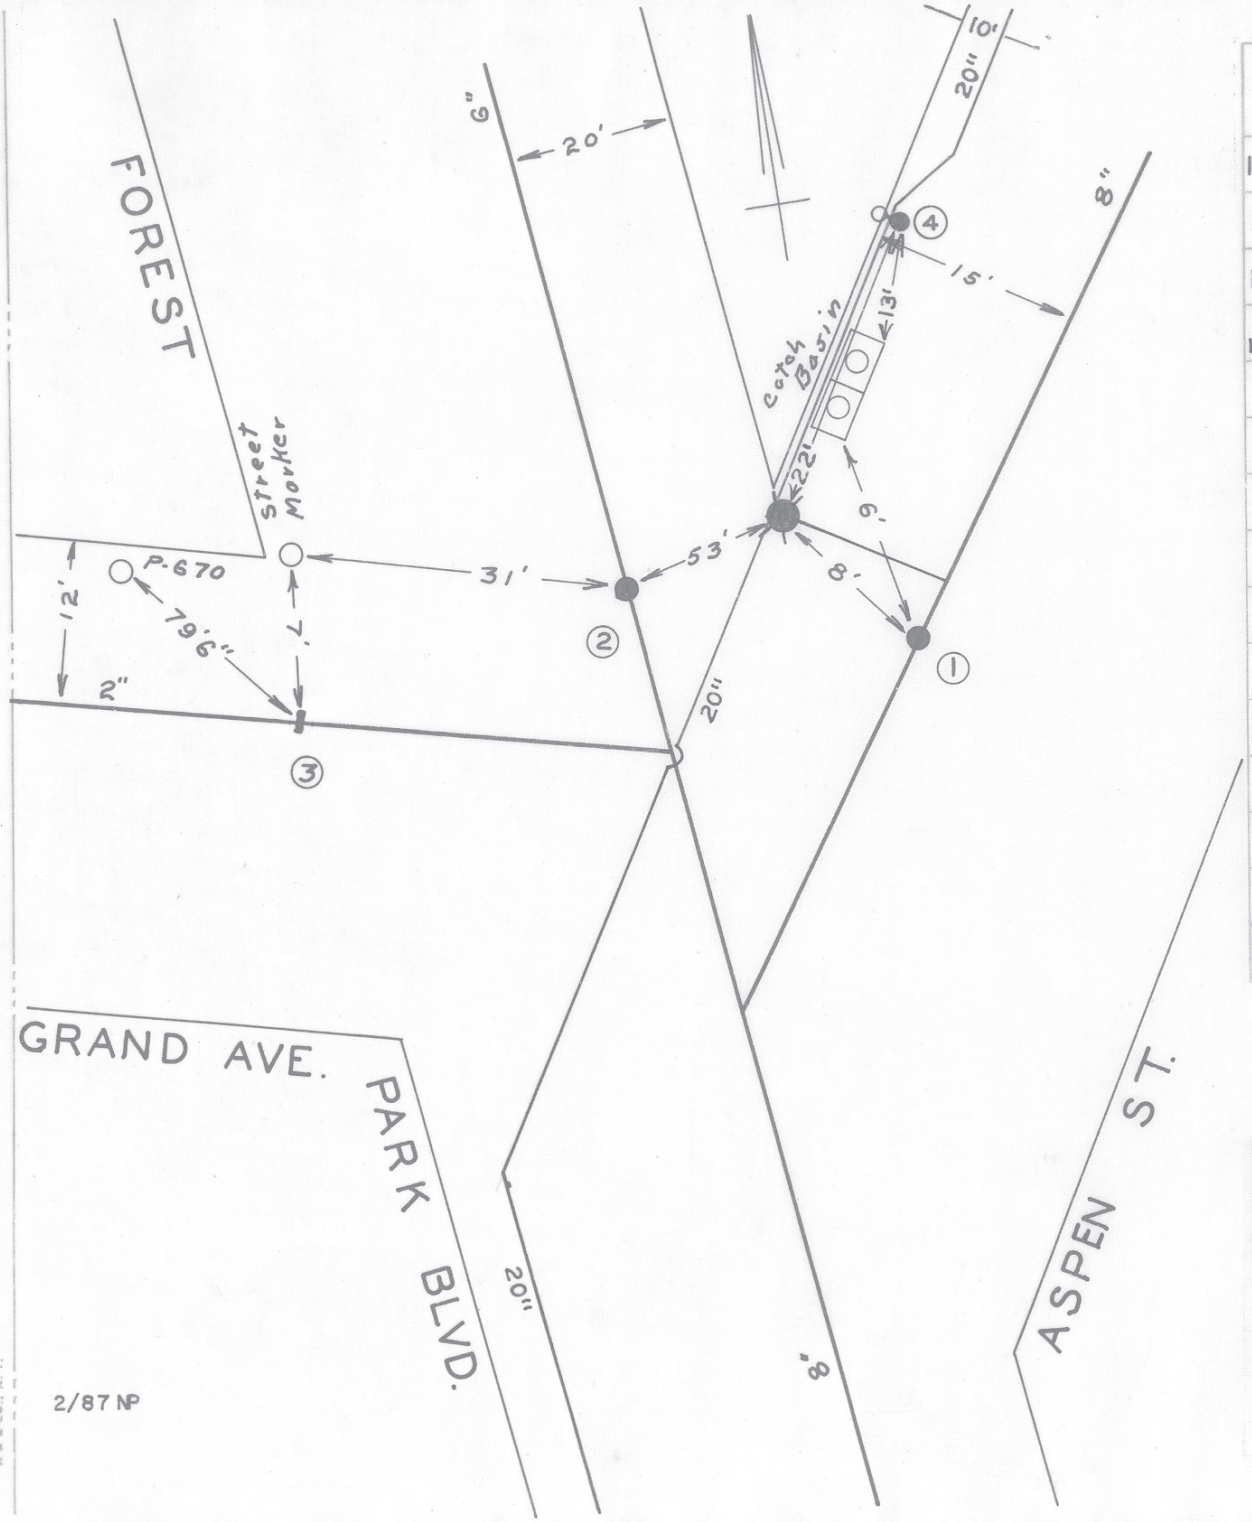

DATE	NO.	SIZE	MAKE	OPEN	TURNS
1947	1	8"	DARLING	R	
1949	2	6"		R	
1946	3	2"		R	
12-64	4	20"	DARLING	R	63
	1	7'-S	NPL		
	2	0	NPL		
	3	0	WPL		

CITY OF ROANOKE—WATER DEPT.

VALVE DIAGRAM

ASPEN ST.-FOREST PARK BLVD. & GRAND AVE. N. W.

SEC. MAP 244

DATE PAGE NO.

2/87 NP

"IMPERIAL" TRACING CLOTH. K & E CO., N. Y.