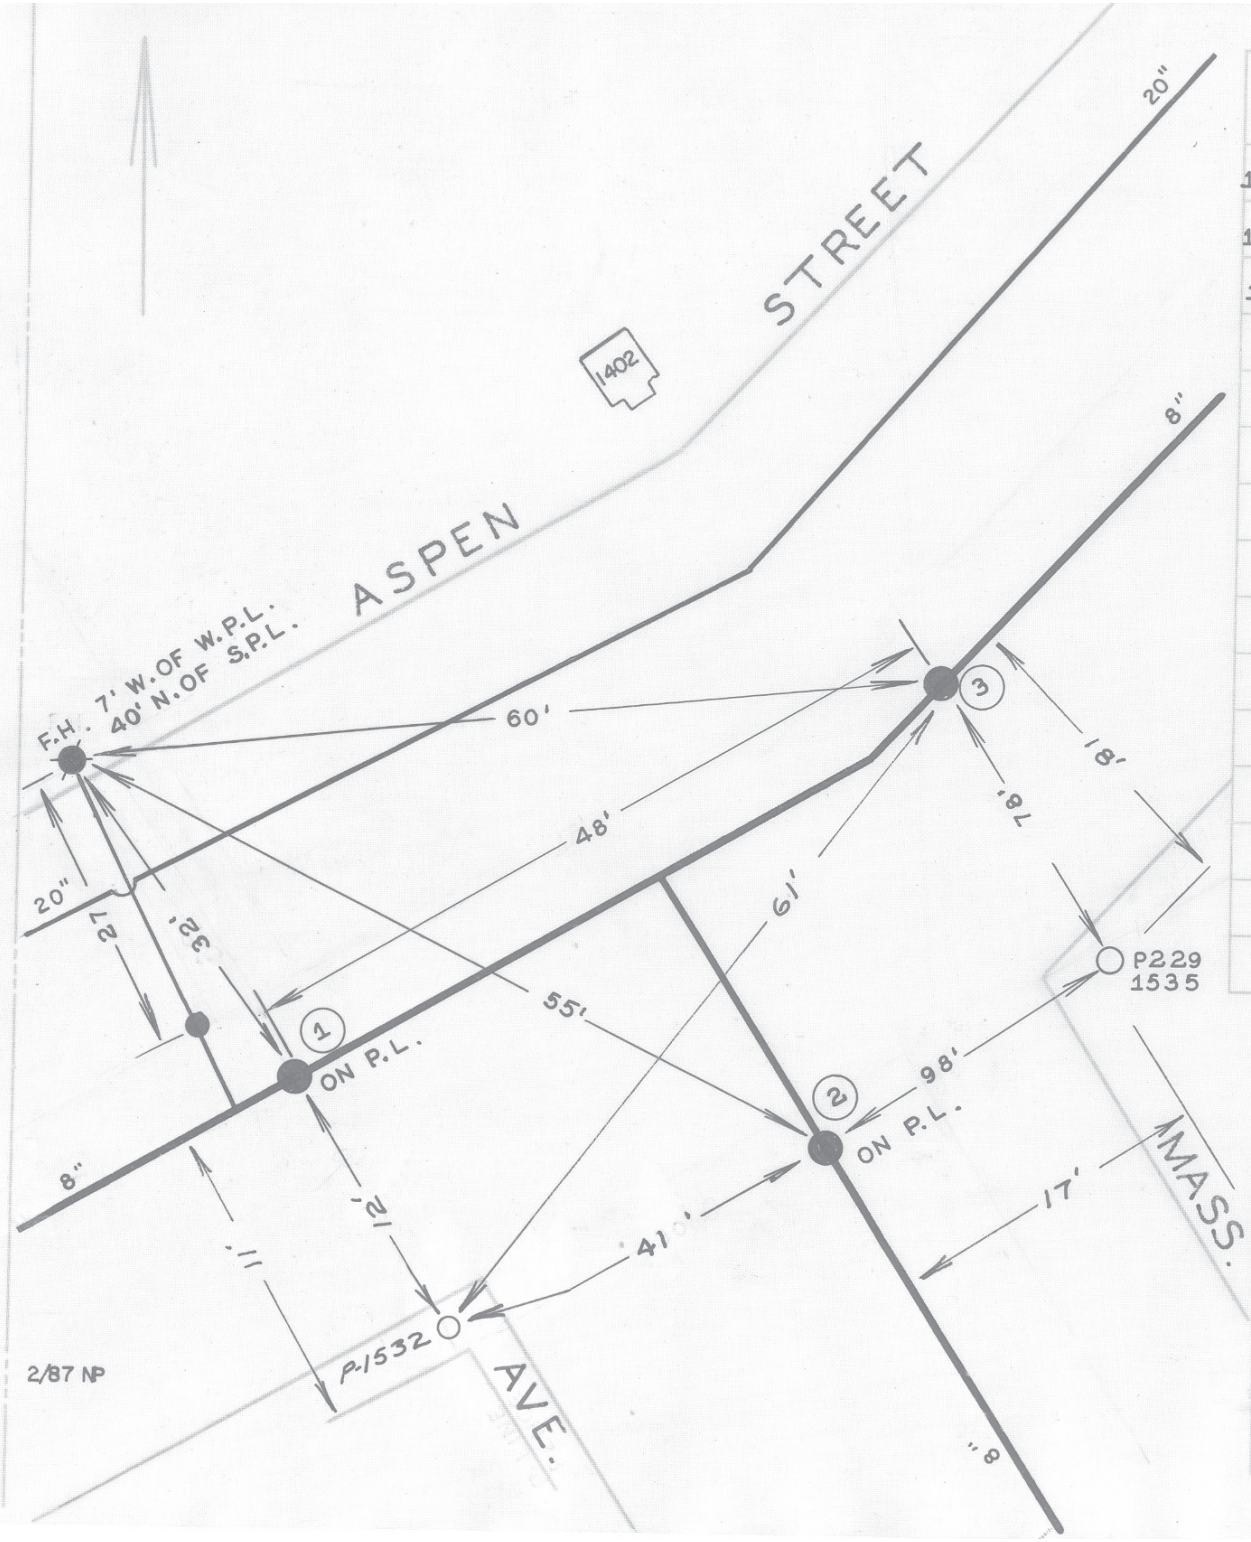

DATE	NO.	SIZE	MAKE	OPEN	TURNS
1949	1	8"	DARLING	R	26 1/2
1949	2	8"	DARLING	R	27
1949	3	8"	DARLING	R	26 1/2
	1	0	SPL		
	2	4'-W	EPL		
	3	0	NPL		

CITY OF ROANOKE—WATER DEP'T

VALVE DIAGRAM

ASPEN STREET &
MASSACHUSETTS AVE. N.W.

SEC. MAP 245, 244

DATE PAGE NO. N.W.264