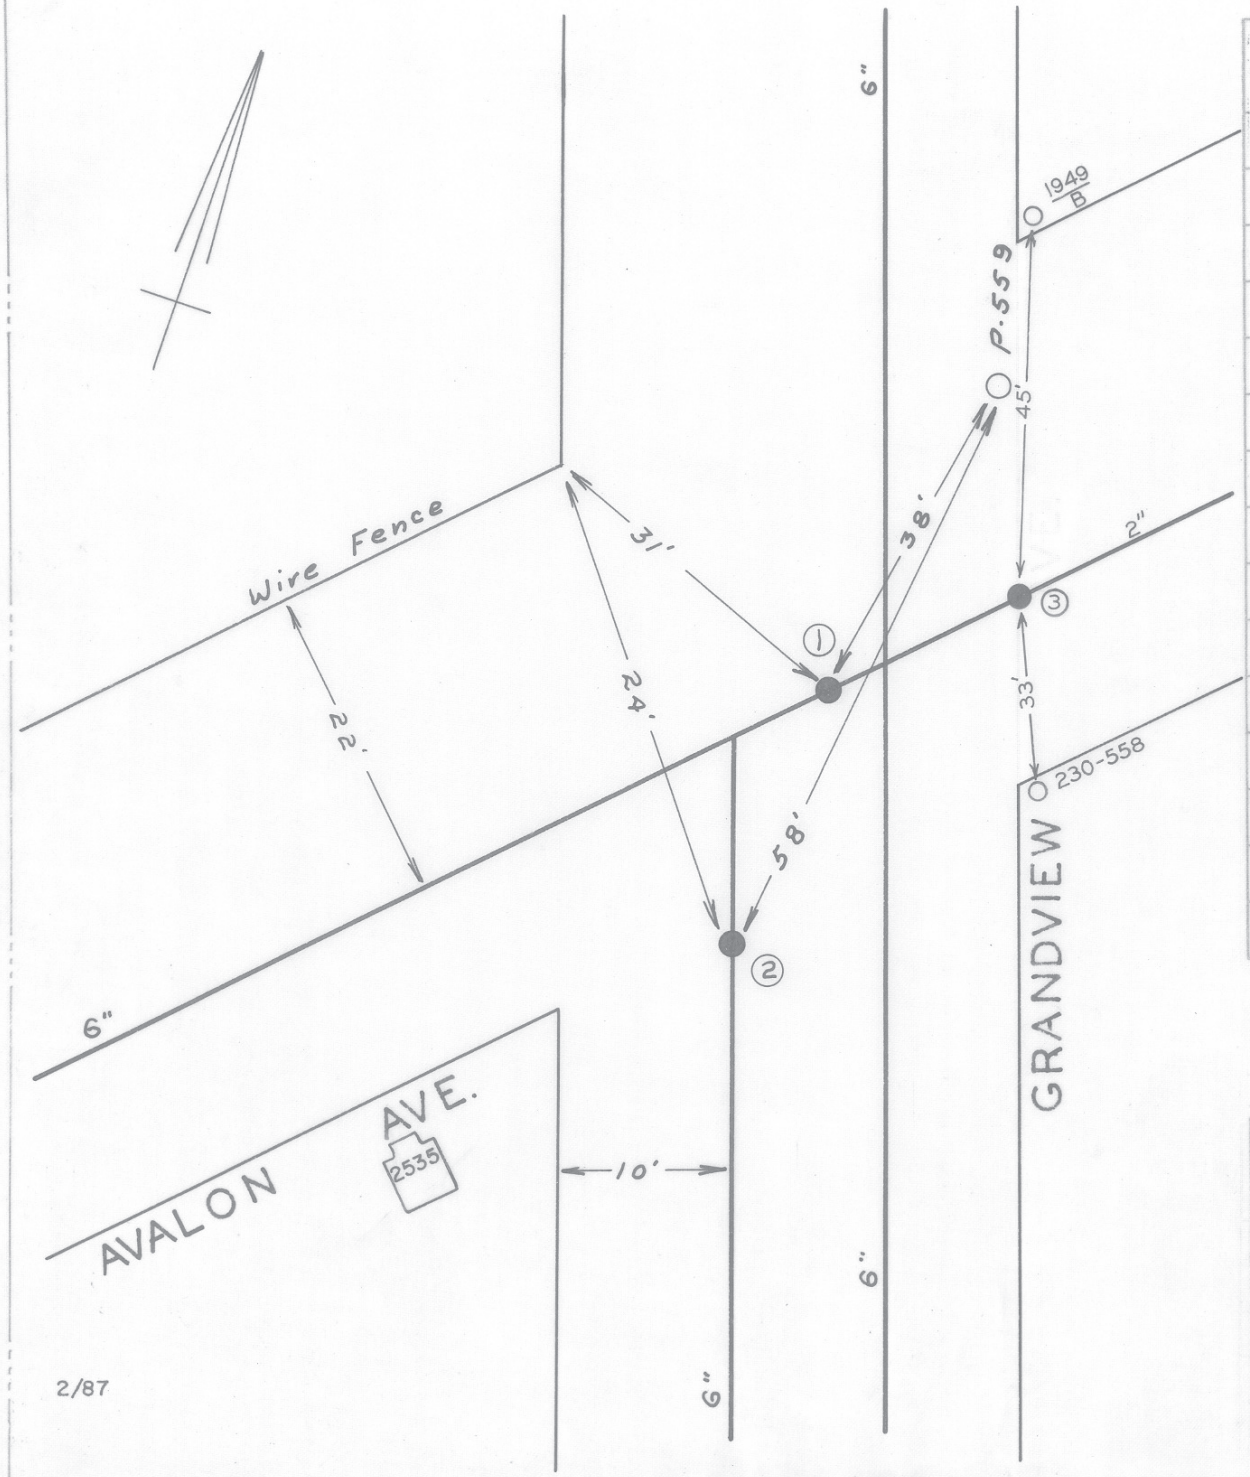

DATE	NO.	SIZE	MAKE	OPEN	TURNS
1951	1	6"			
1951	2	6"			
71	3	2"	MUELLER	R	
	1	28'-E	WPL		
	2	0	SPL		

CITY OF ROANOKE—WATER DEPT.

VALVE DIAGRAM

AVALON AVE. & GRANDVIEW AVE. N.W.

SEC. MAP 226

DATE PAGE NO.

2/87

"IMPERIAL" TRACING CLOTH. K & E CO., N. Y.