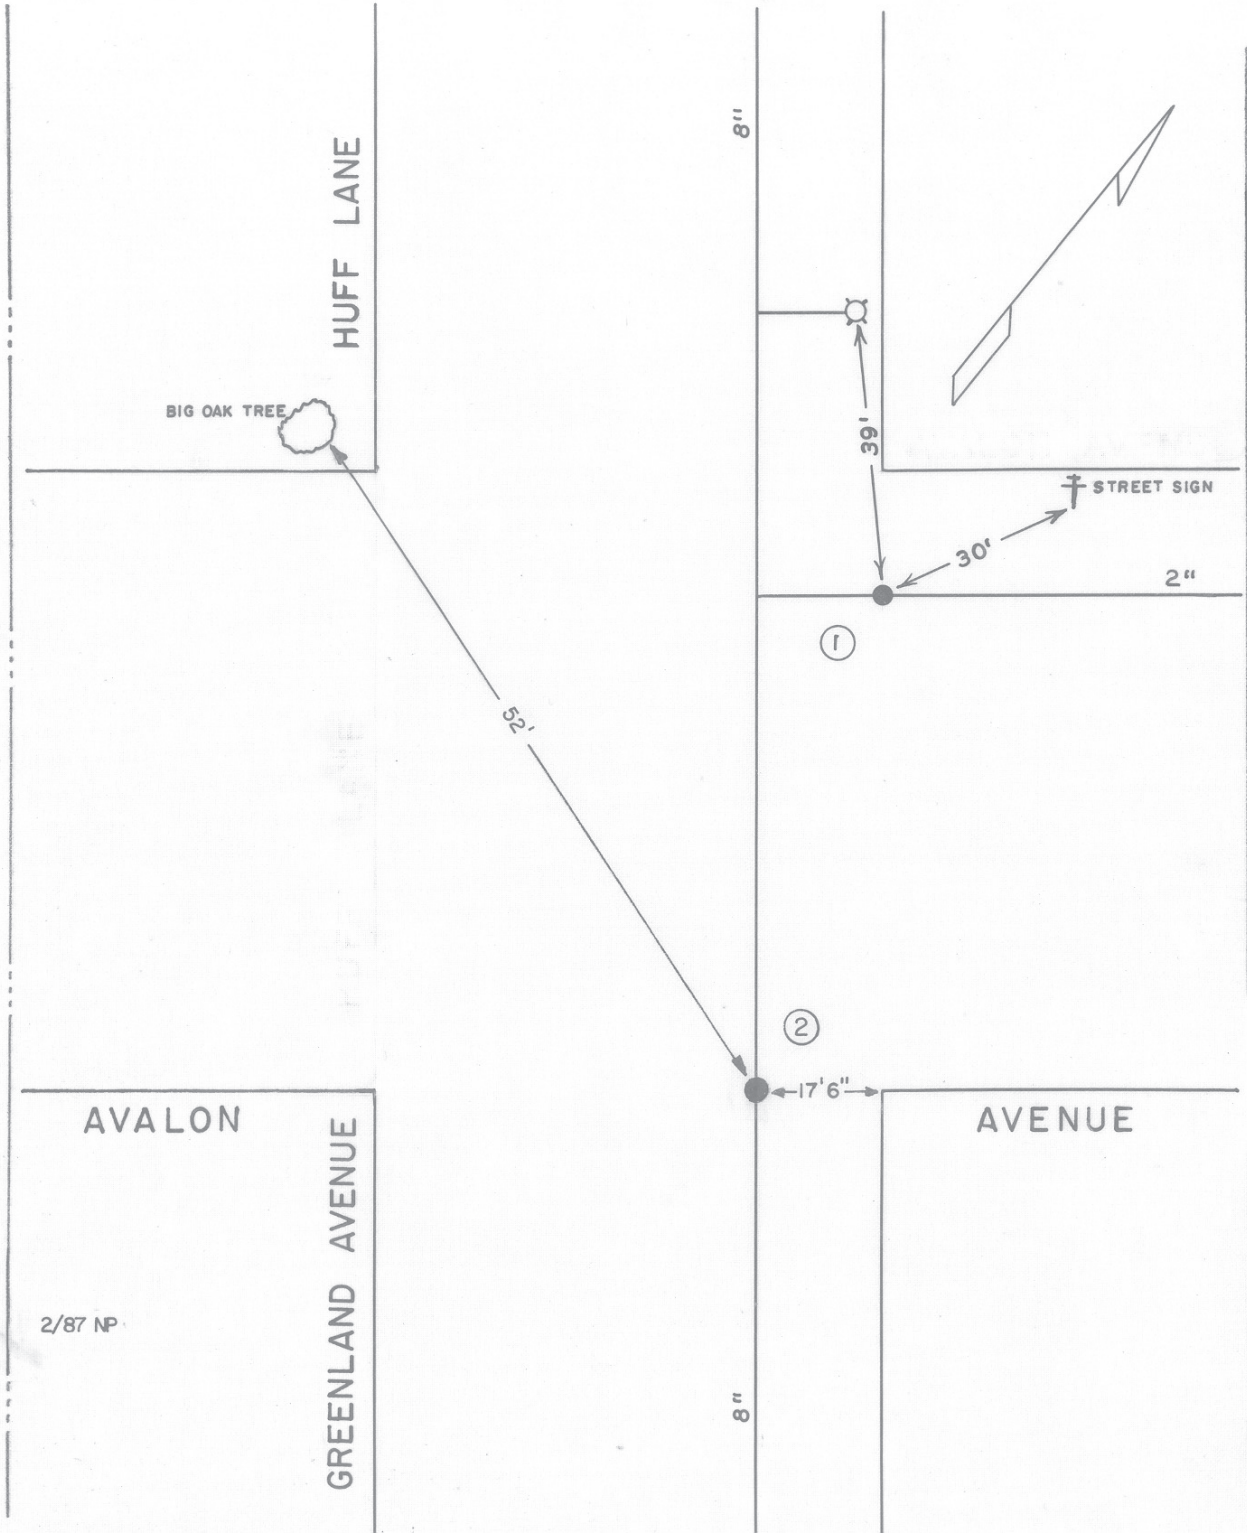

DATE	NO.	SIZE	MAKE	OPEN	TURNS
11-60	1	2"	DARLING	R	
1956	2	8"	DARLING	R	
	1	0	E. P. L.		

CITY OF ROANOKE — WATER DEPT.

VALVE DIAGRAM

AVALON AVENUE

GREENLAND AVENUE

HUFF LANE

SEC. MAP 226, 225 N.W.

DATE PAGE NO.