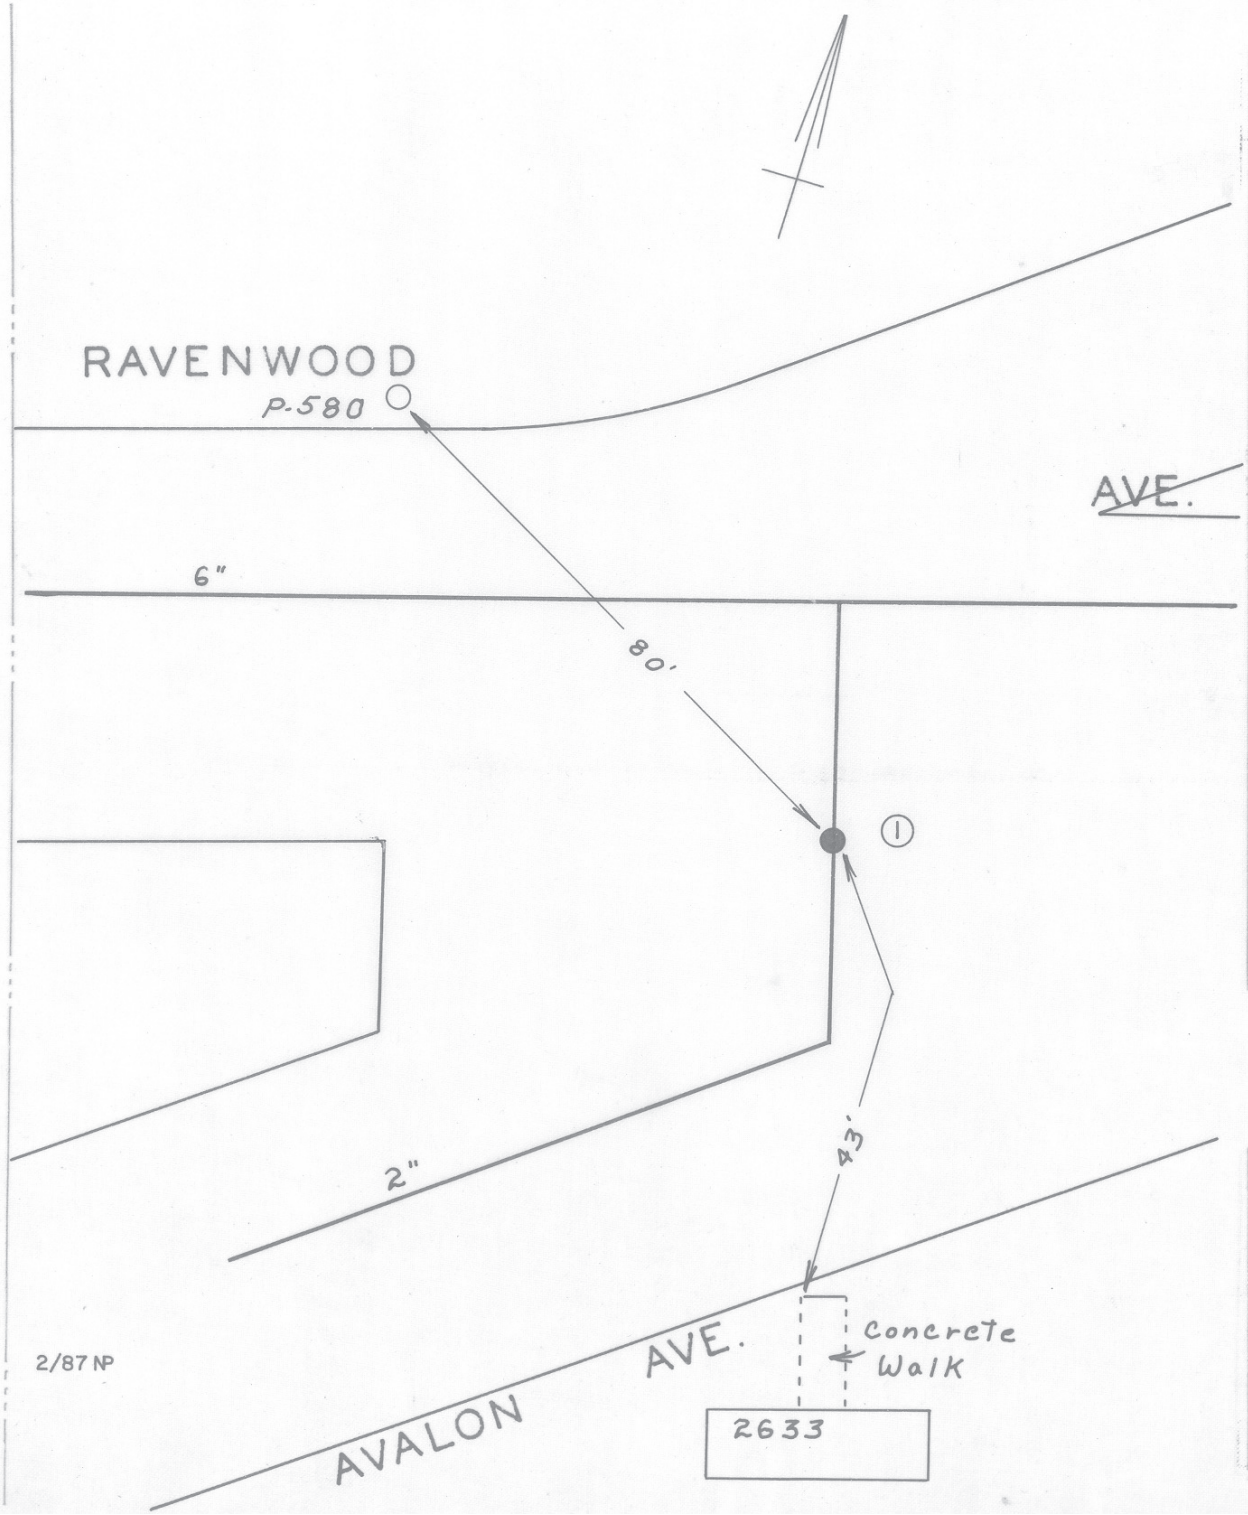

DATE	NO.	SIZE	MAKE	OPEN	TURNS
1953	1	2"			
	1	0	SPL		

CITY OF ROANOKE—WATER DEPT.

VALVE DIAGRAM

AVALON AVE. & RAVENWOOD AVE. N. W.

SEC. MAP 226

DATE PAGE NO.

"IMPERIAL" TRACING CLOTH K & E CO., N.Y.