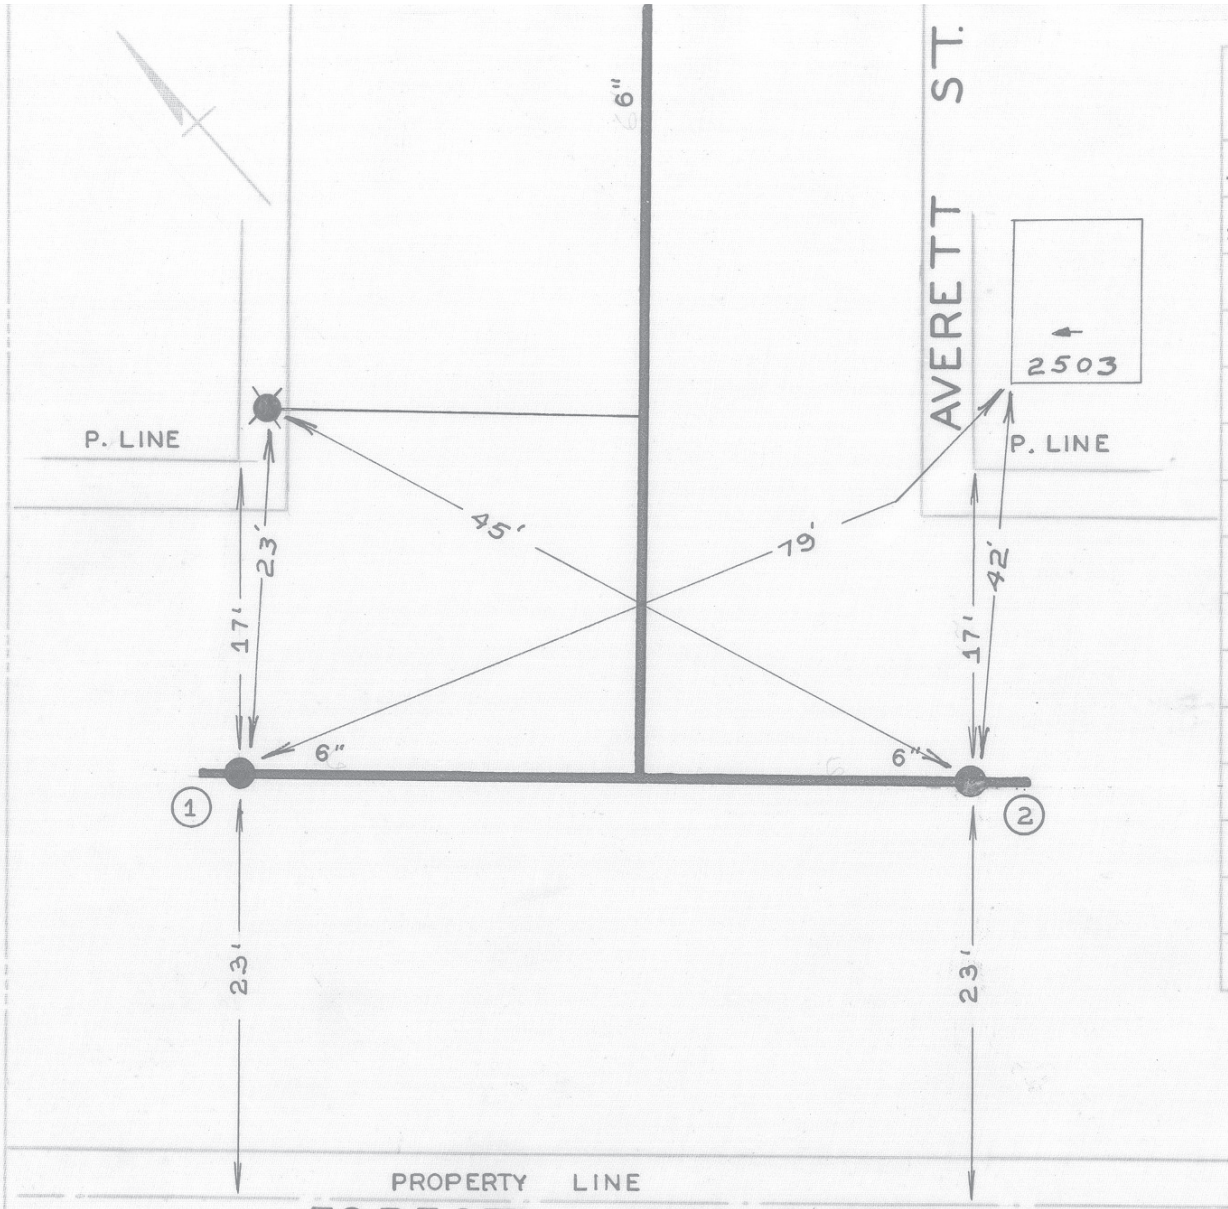

DATE	NO.	SIZE	MAKE	OPEN	TURNS
1950	1	6"	DARLING	R	21
1950	2	6"	DARLING	R	21
	1	0	WPL		
	2	0	EPL		

2/87 NP

CITY OF ROANOKE — WATER DEP'T

VALVE DIAGRAM

AVERETT STREET &
FOREST HILL AVE. N.W.

SEC. MAP 207

DATE 5/29/50 PAGE NO NW 324