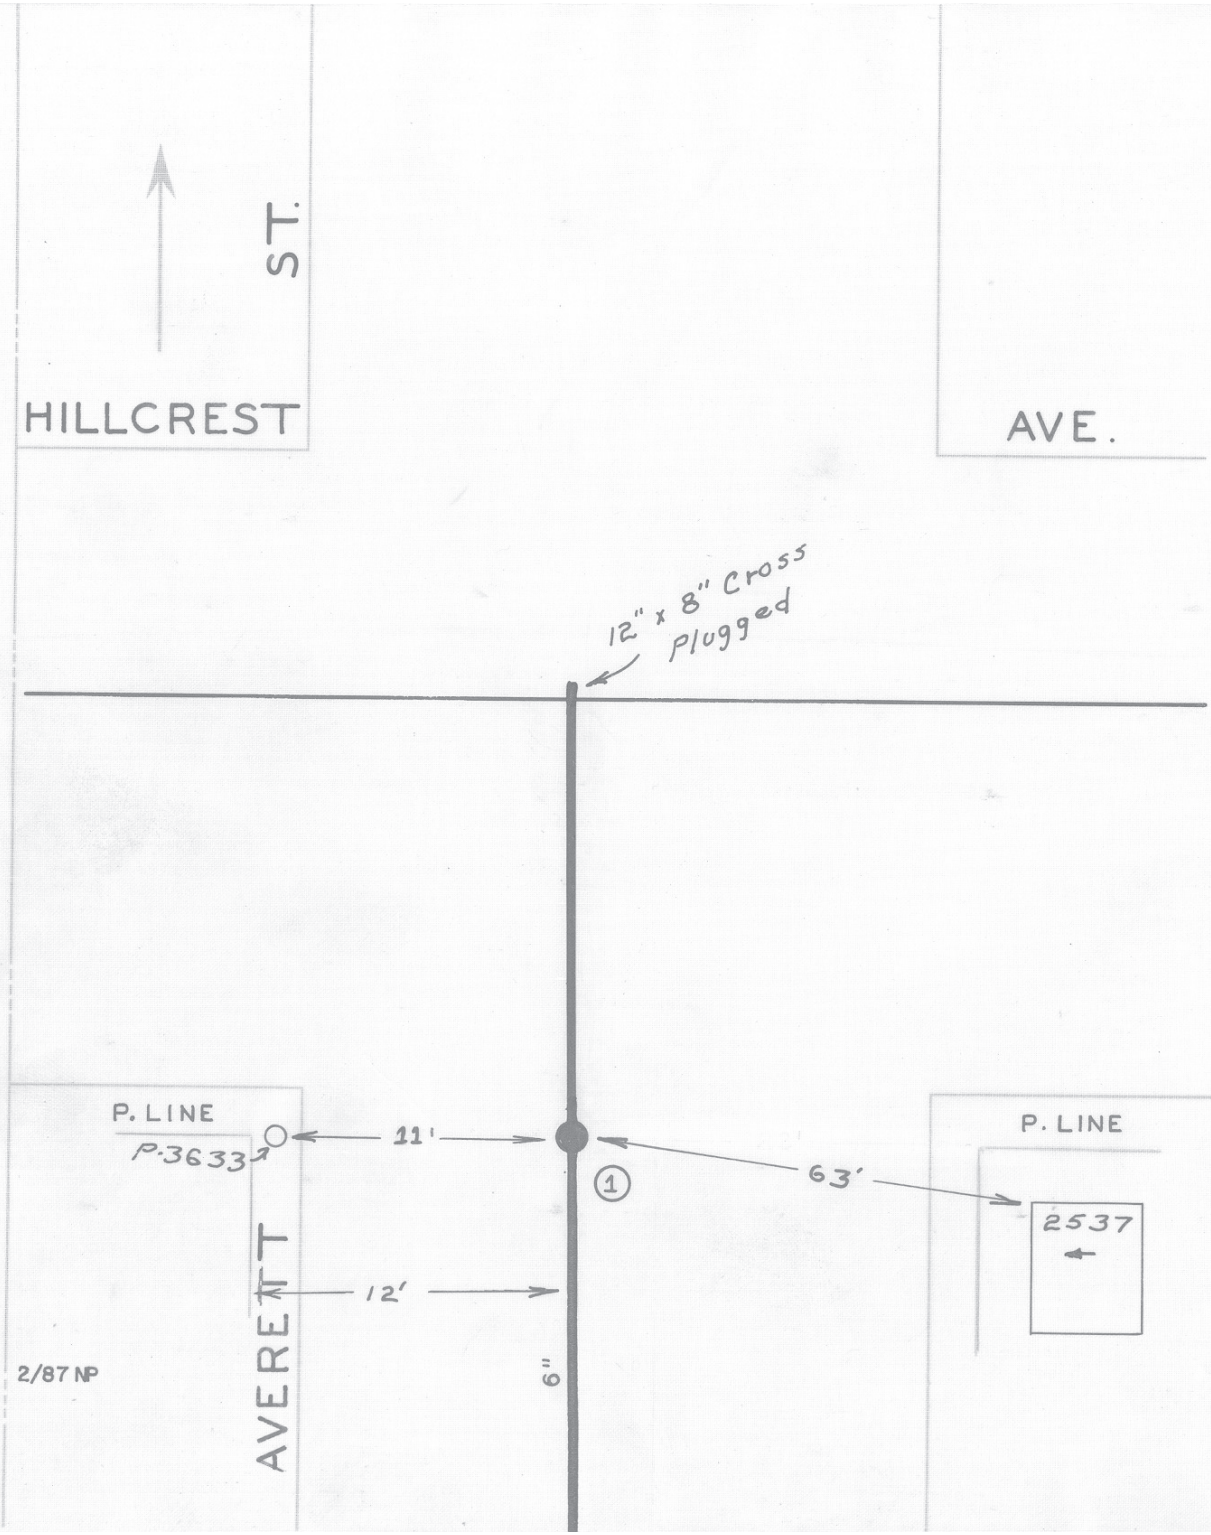

DATE	NO.	SIZE	MAKE	OPEN	TURNS
1950	1	6"	DARLING	R	21
	1	0	SPL		

CITY OF ROANOKE—WATER DEP'T

VALVE DIAGRAM

AVERETT STREET &
HILLCREST AVE. N.W.

SEC. MAP 207

DATE 5/29/50 PAGE NO. N.W.325