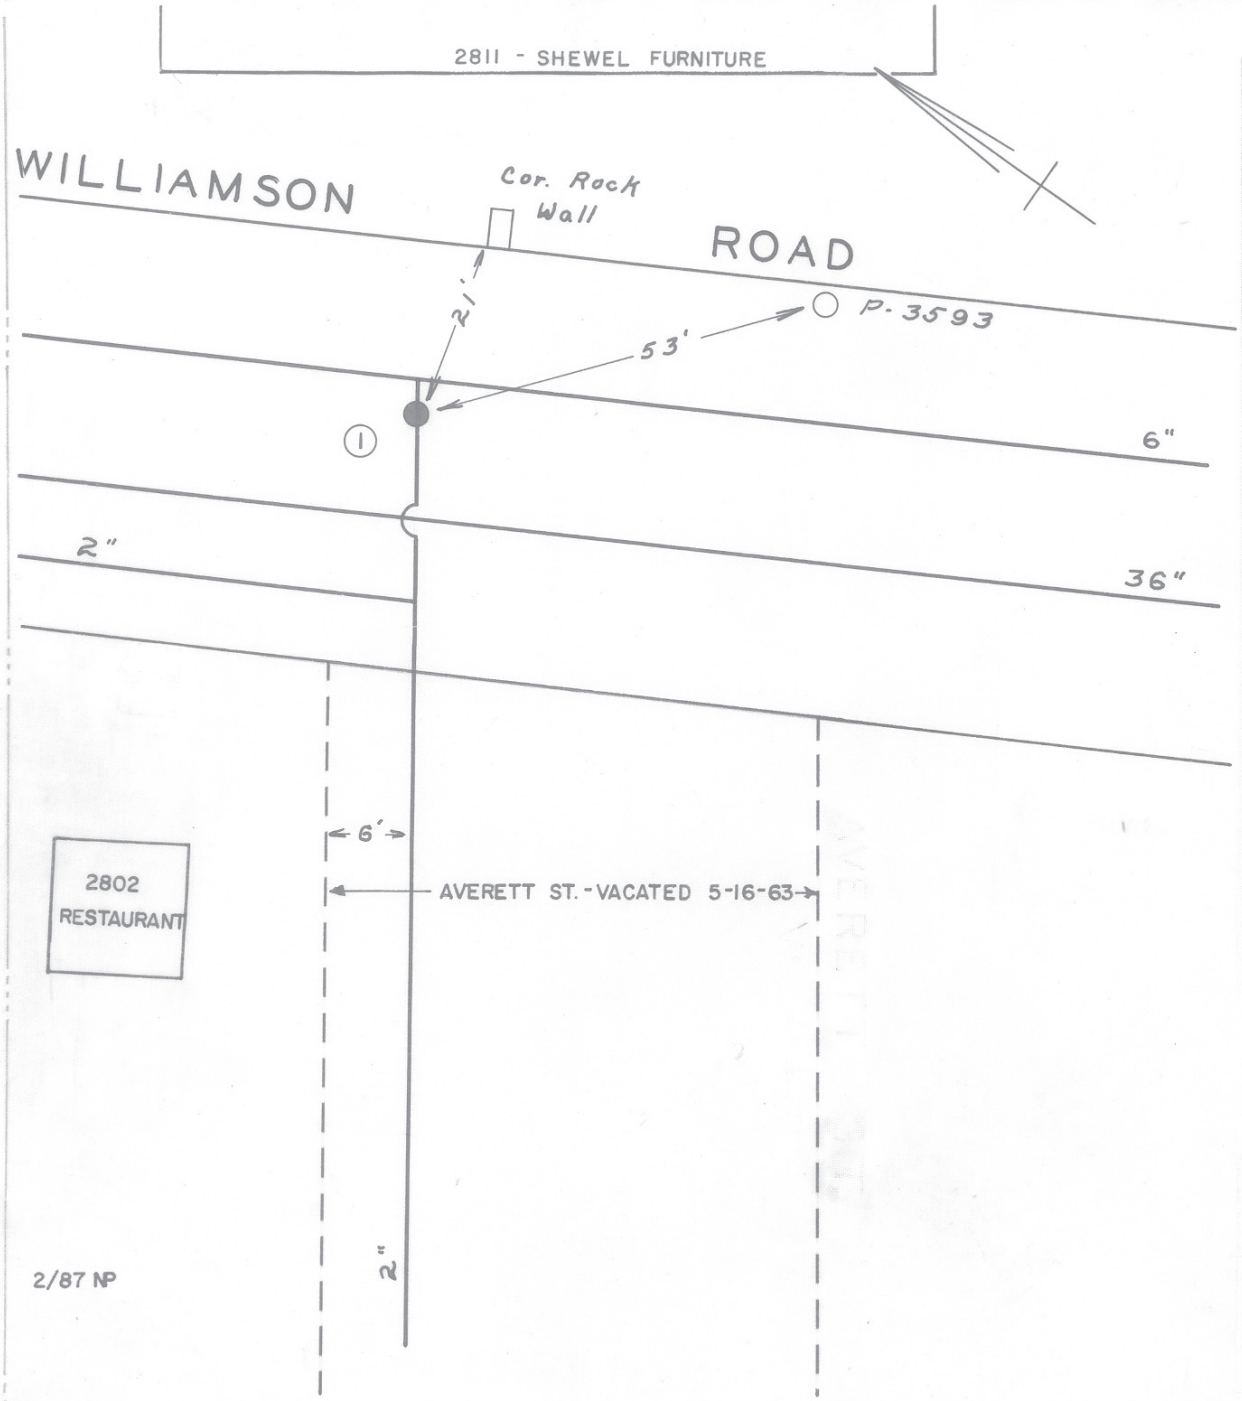

DATE	NO.	SIZE	MAKE	OPEN	TURNS
W.R. 1953	1	2"			
	1	16'-W	EPL		

CITY OF ROANOKE—WATER DEPT.

VALVE DIAGRAM

AVERETT ST. & WILLIAMSON ROAD N.W. OR N.E.

SEC. MAP 207, 310 N.W. OR N.E.

DATE PAGE NO.

"IMPERIAL" TRACING CLOTH. K.&E. CO., N.Y.