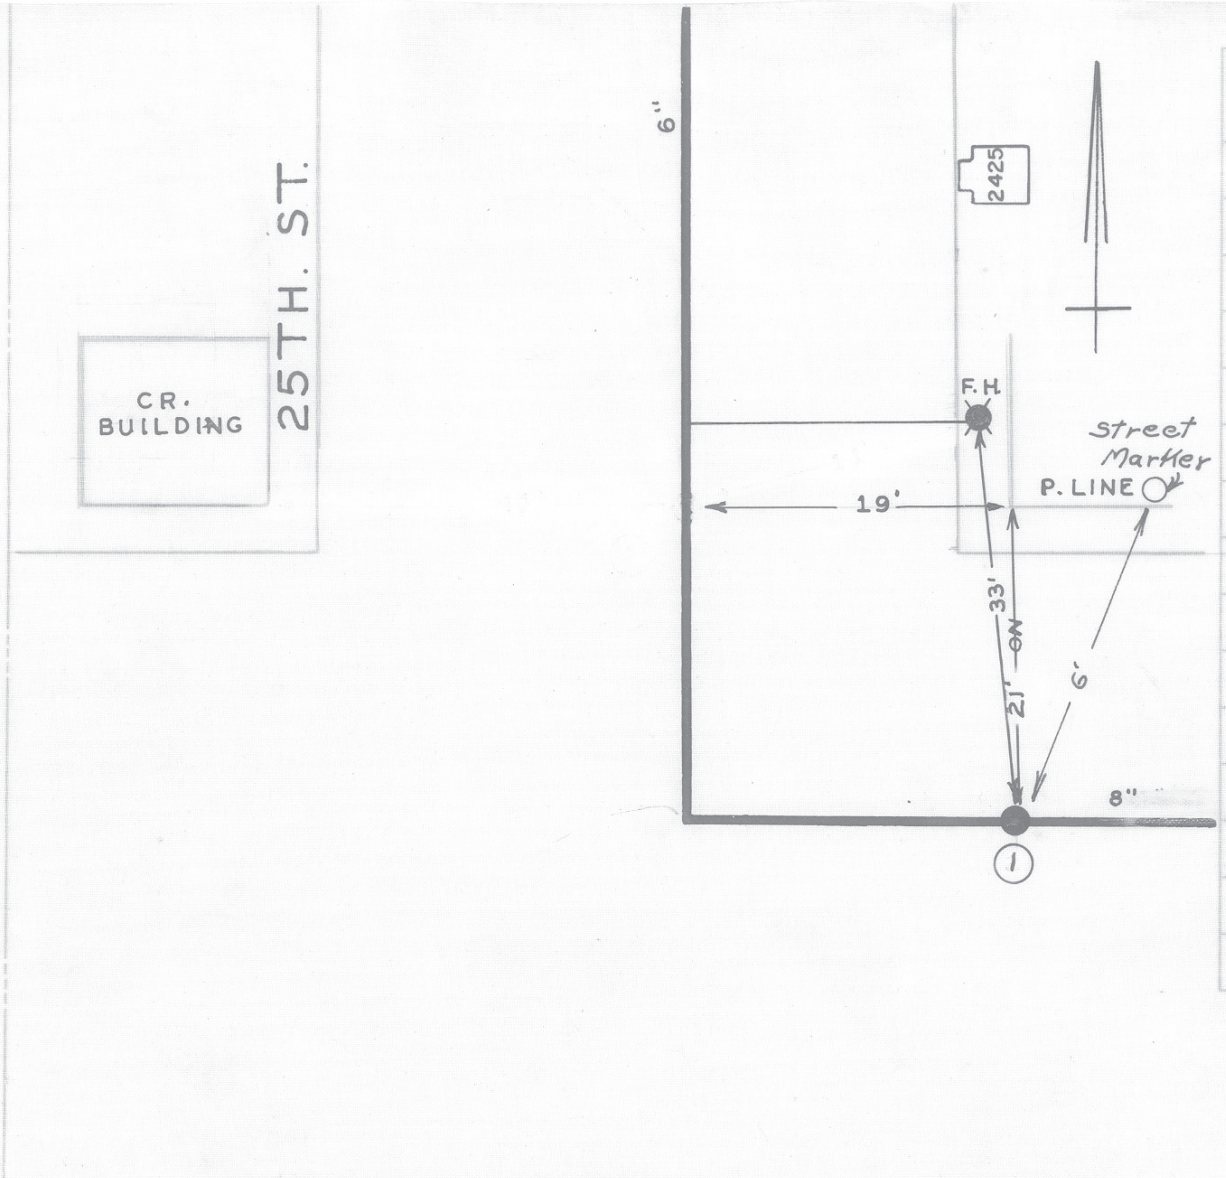

DATE	NO.	SIZE	MAKE	OPEN	TURNS
1952	1	8	MUELLER	R	26
	1	0	EPL		

CITY OF ROANOKE—WATER DEP'T

VALVE DIAGRAM

BAKER AVENUE &

25TH. STREET N.W.

SEC. MAP 241

DATE 1/8/51 PAGE NO. NW332

2/87 NP