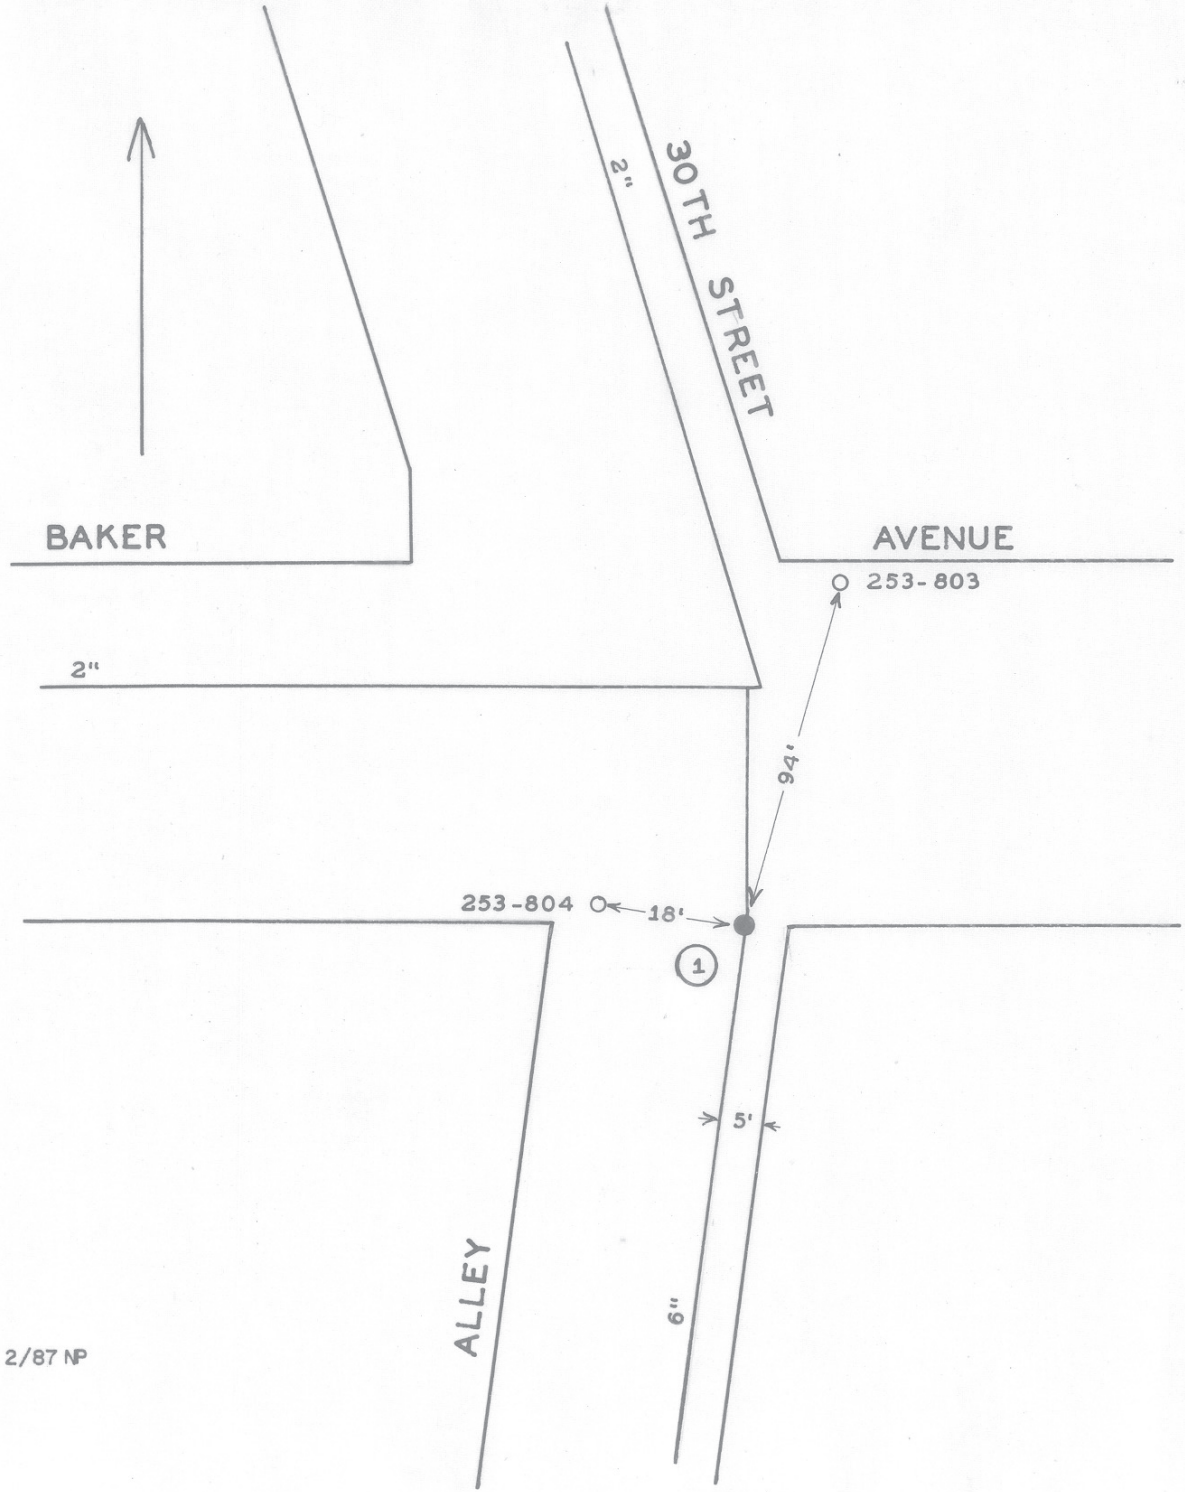

DATE	NO.	SIZE	MAKE	OPEN	TURNS
8-60	1	6"	DARLING	R	
	1	0	S.P.L.		

CITY OF ROANOKE — WATER DEPT.

VALVE DIAGRAM

BAKER AVENUE & 30TH STREET N. W.

SEC. MAP 241

DATE DATE PAGE NO.

2187

2/87 NP

"IMPERIAL" TRACING CLOTH K & E CO., N. Y.