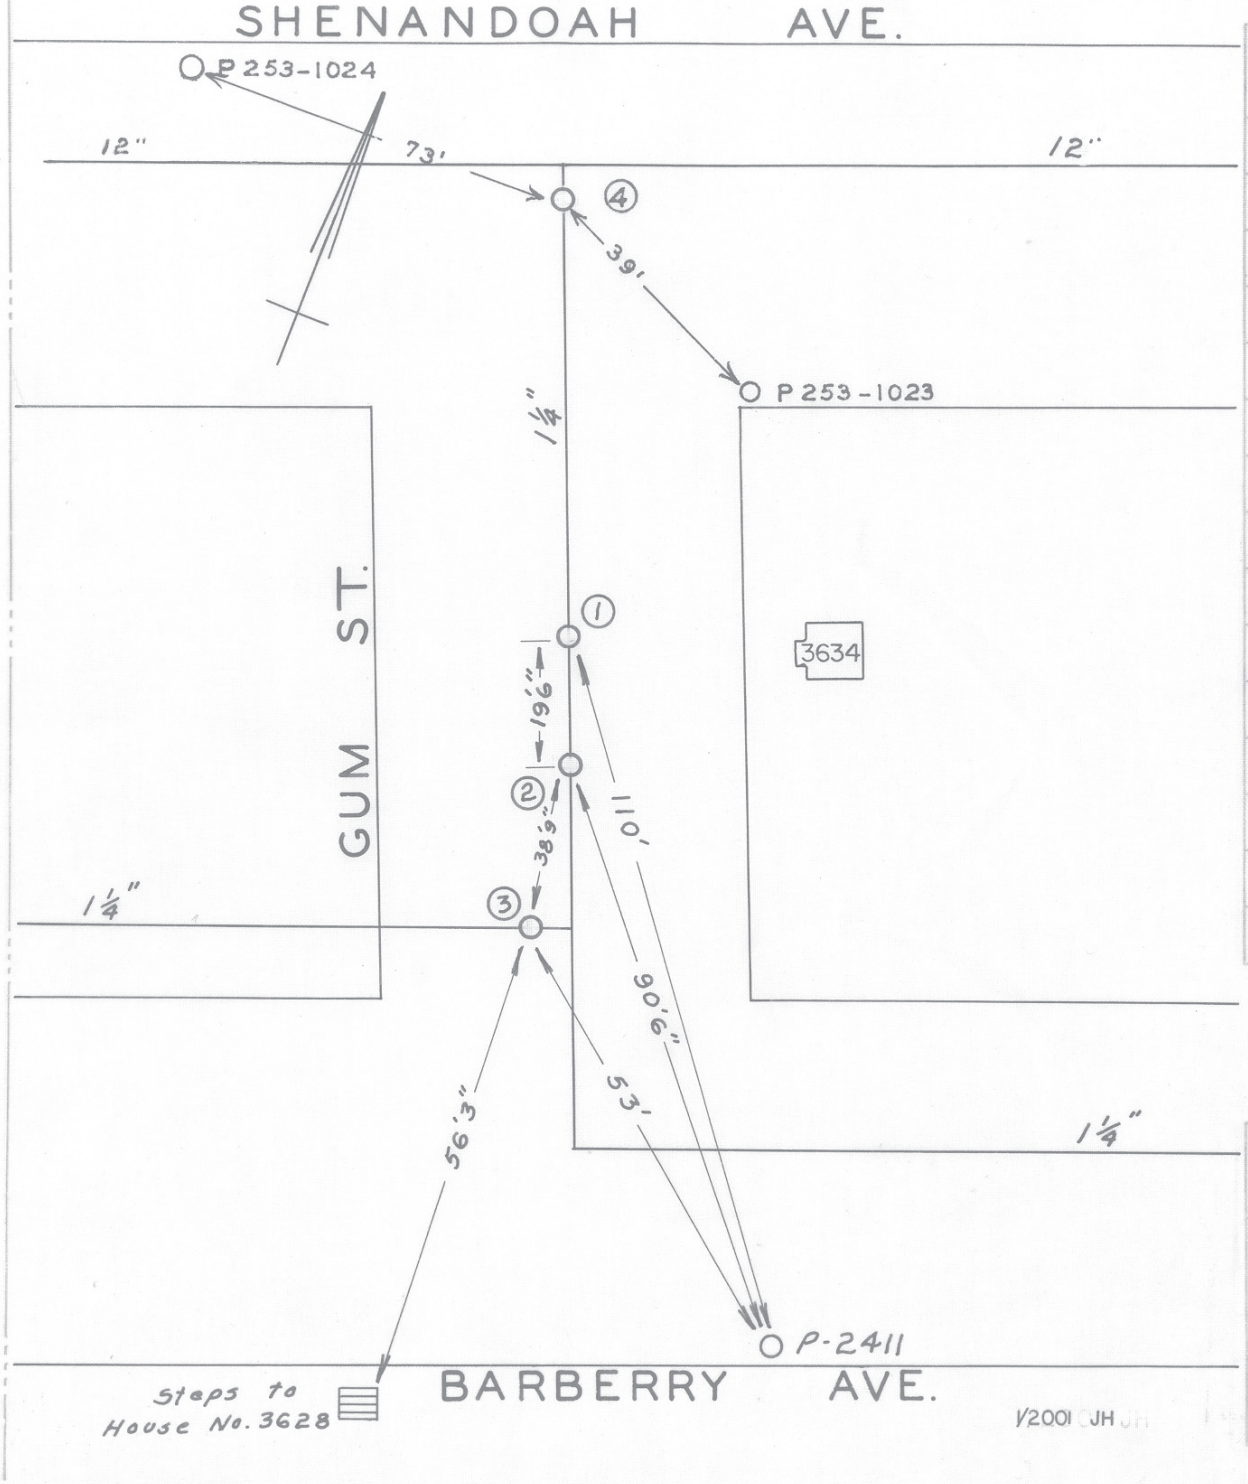

DATE	NO.	SIZE	MAKE	OPEN	TURNS
1957	1	1¼"		L	
1957	2	1¼"		L	
1957	3	1¼"		L	
59'	4	1½"		L	

CITY OF ROANOKE—WATER DEPT.

VALVE DIAGRAM

BARBERRY AVE. &

GUM STREET &

SHENANDOAH AVE.

SEC. MAP 263 N.W.

DATE PAGE NO.

"IMPERIAL" TRACING CLOTH. K & E CO., N. Y.