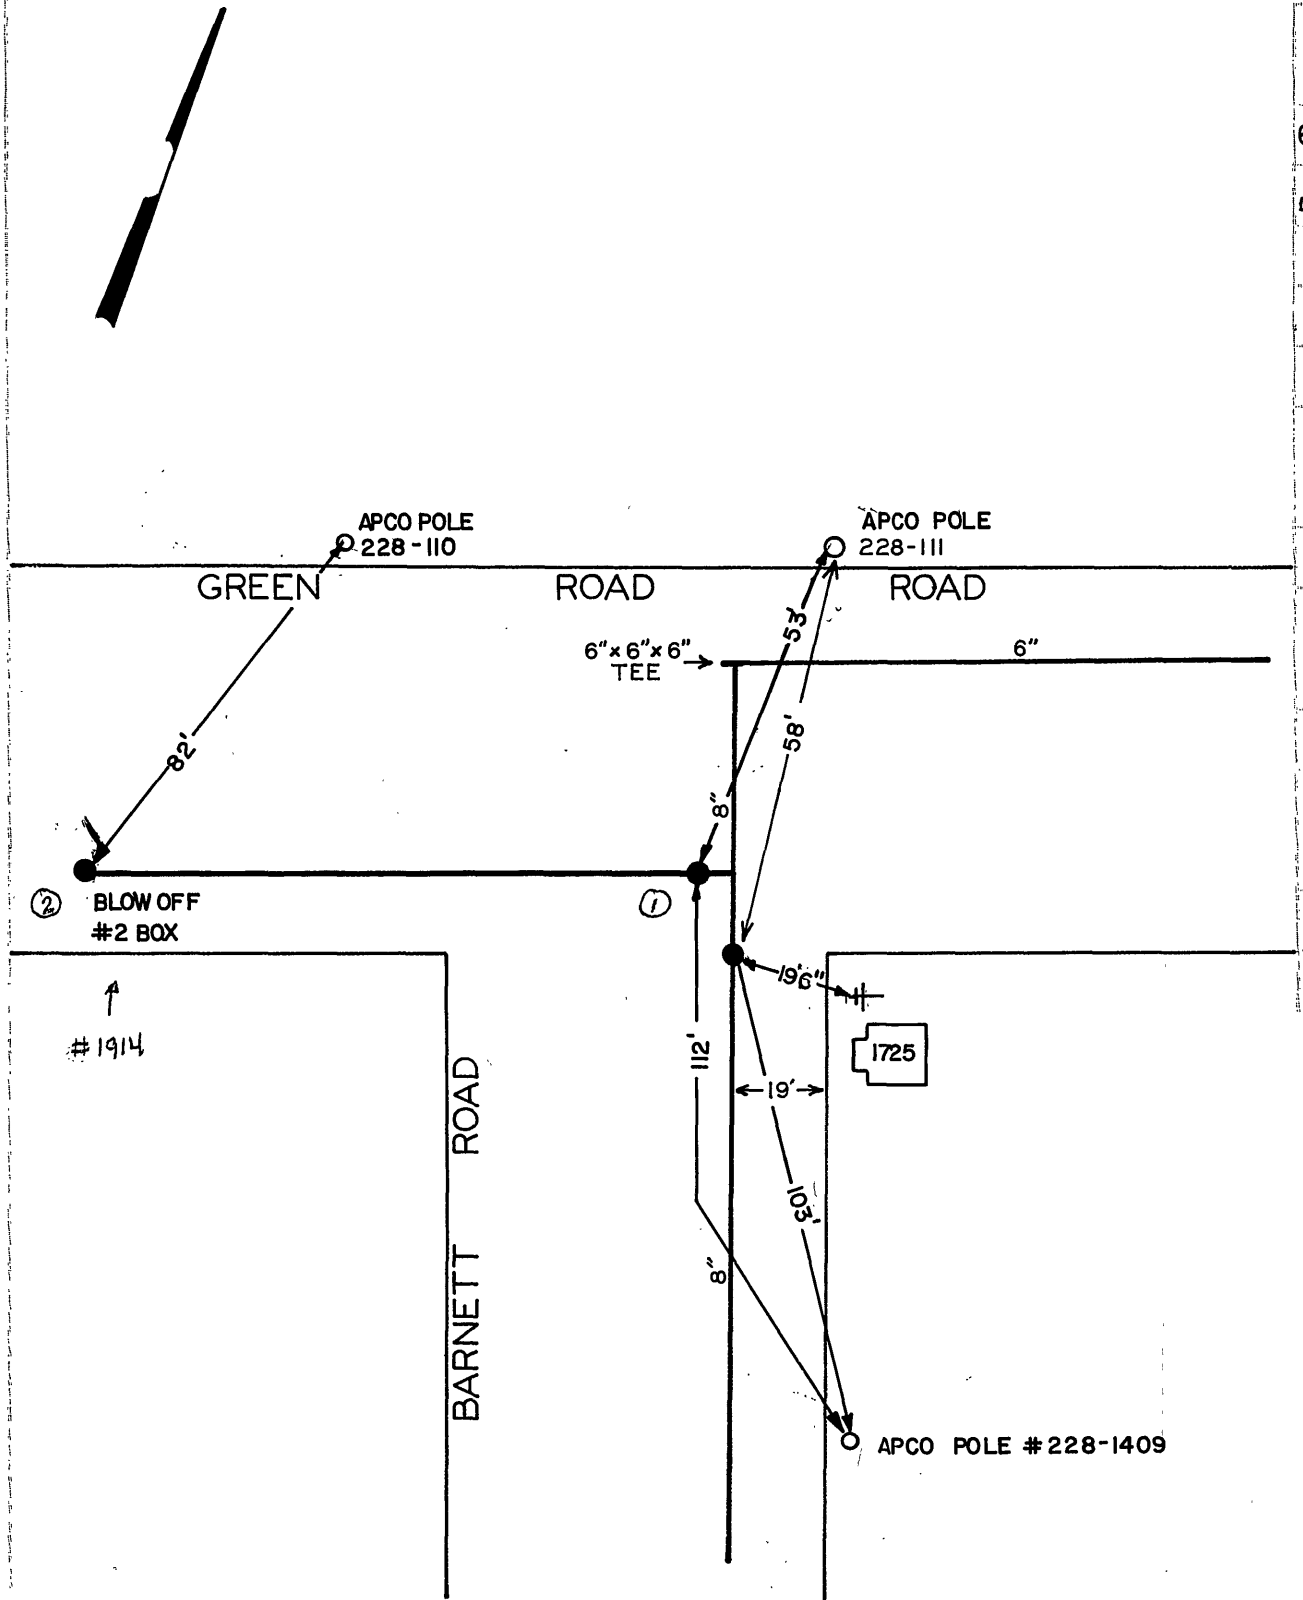

DATE	NO.	SIZE	MAKE	OPEN	TURNS
6-70	1	8"	MUELLER	R	27
4-92	2	2"	Misc.		

CITY OF ROANOKE—WATER DEPT.
VALVE DRAWING

BARNETT ROAD & GREEN RIDGE ROAD N.W.

SHEET NO. 615

DATE PAGE NO.