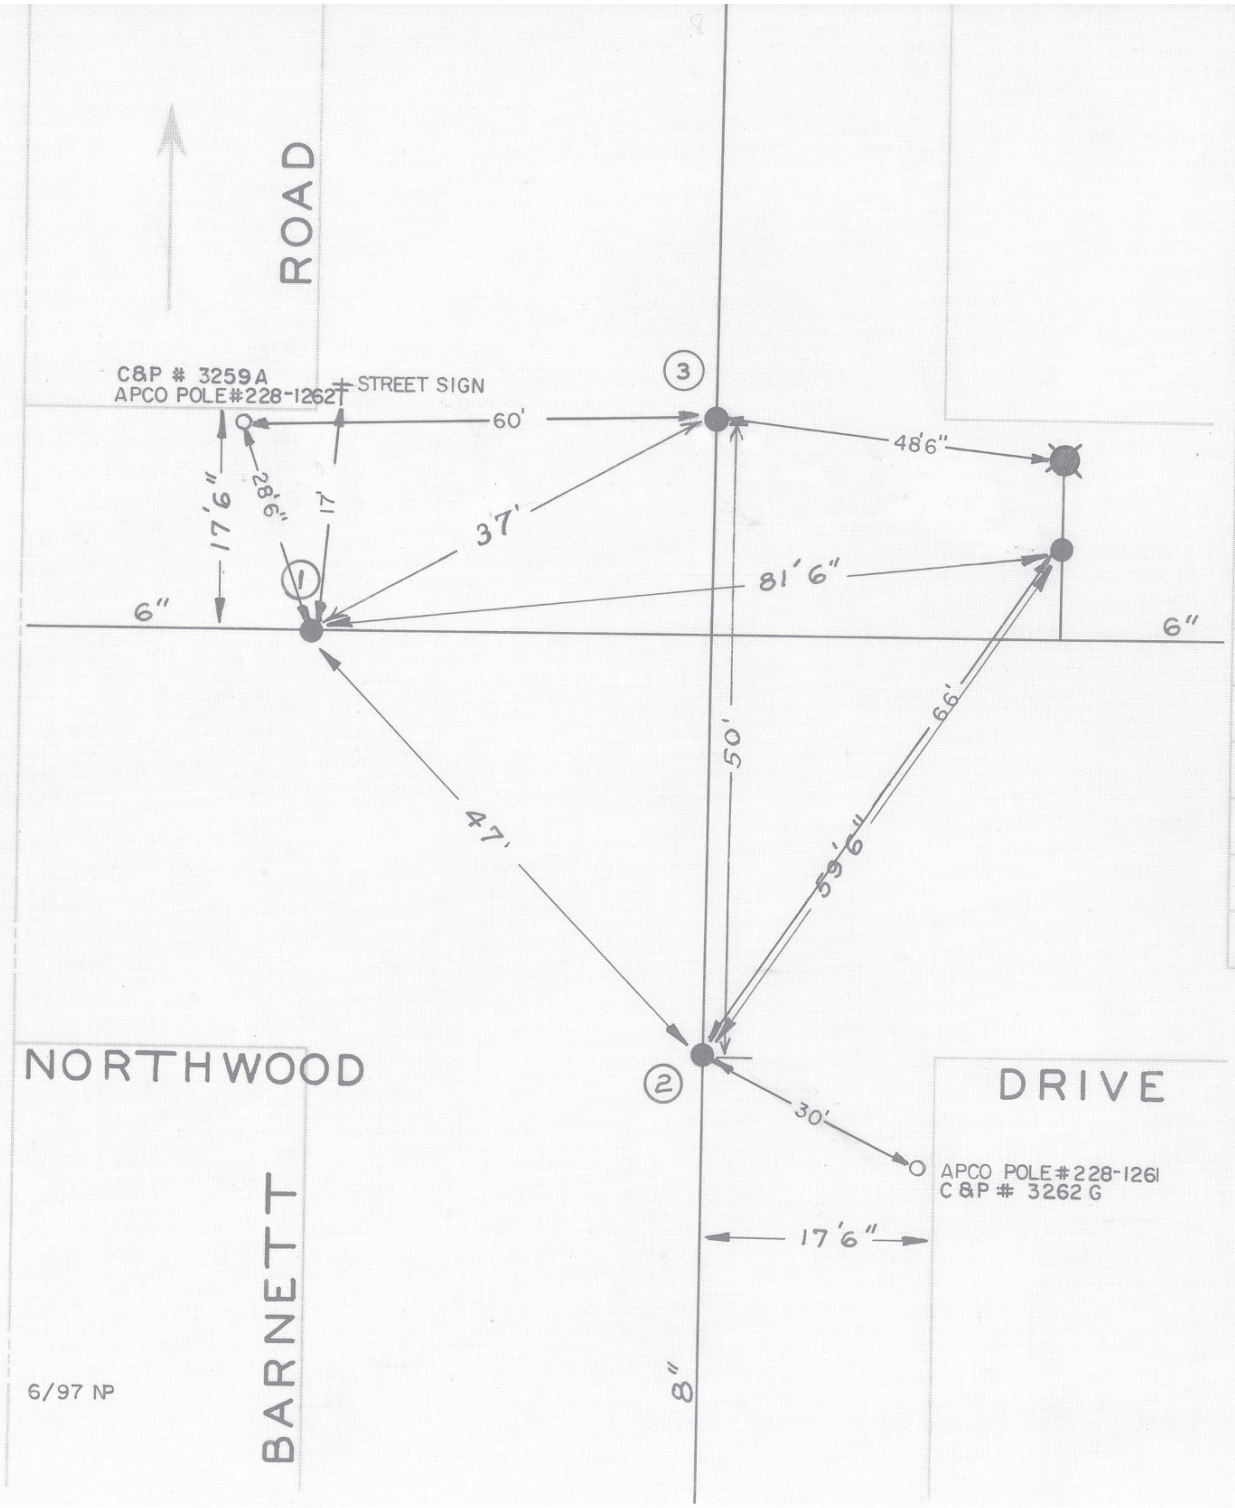

DATE	NO.	SIZE	MAKE	OPEN	TURNS
'58	1	6"	MUELLER	R	20½
'58	2	8"	DARLING	R	27
'61	3	8"	MUELLER	R	26
	1	0	WPL		
	2	0	SPL		
	3	0	NPL		

CITY OF ROANOKE—WATER DEP'T

VALVE DIAGRAM

BARNETT ROAD &
NORTHWOOD DR. N. W.

SEC. MAP 613 (2)

DATE PAGE NO.