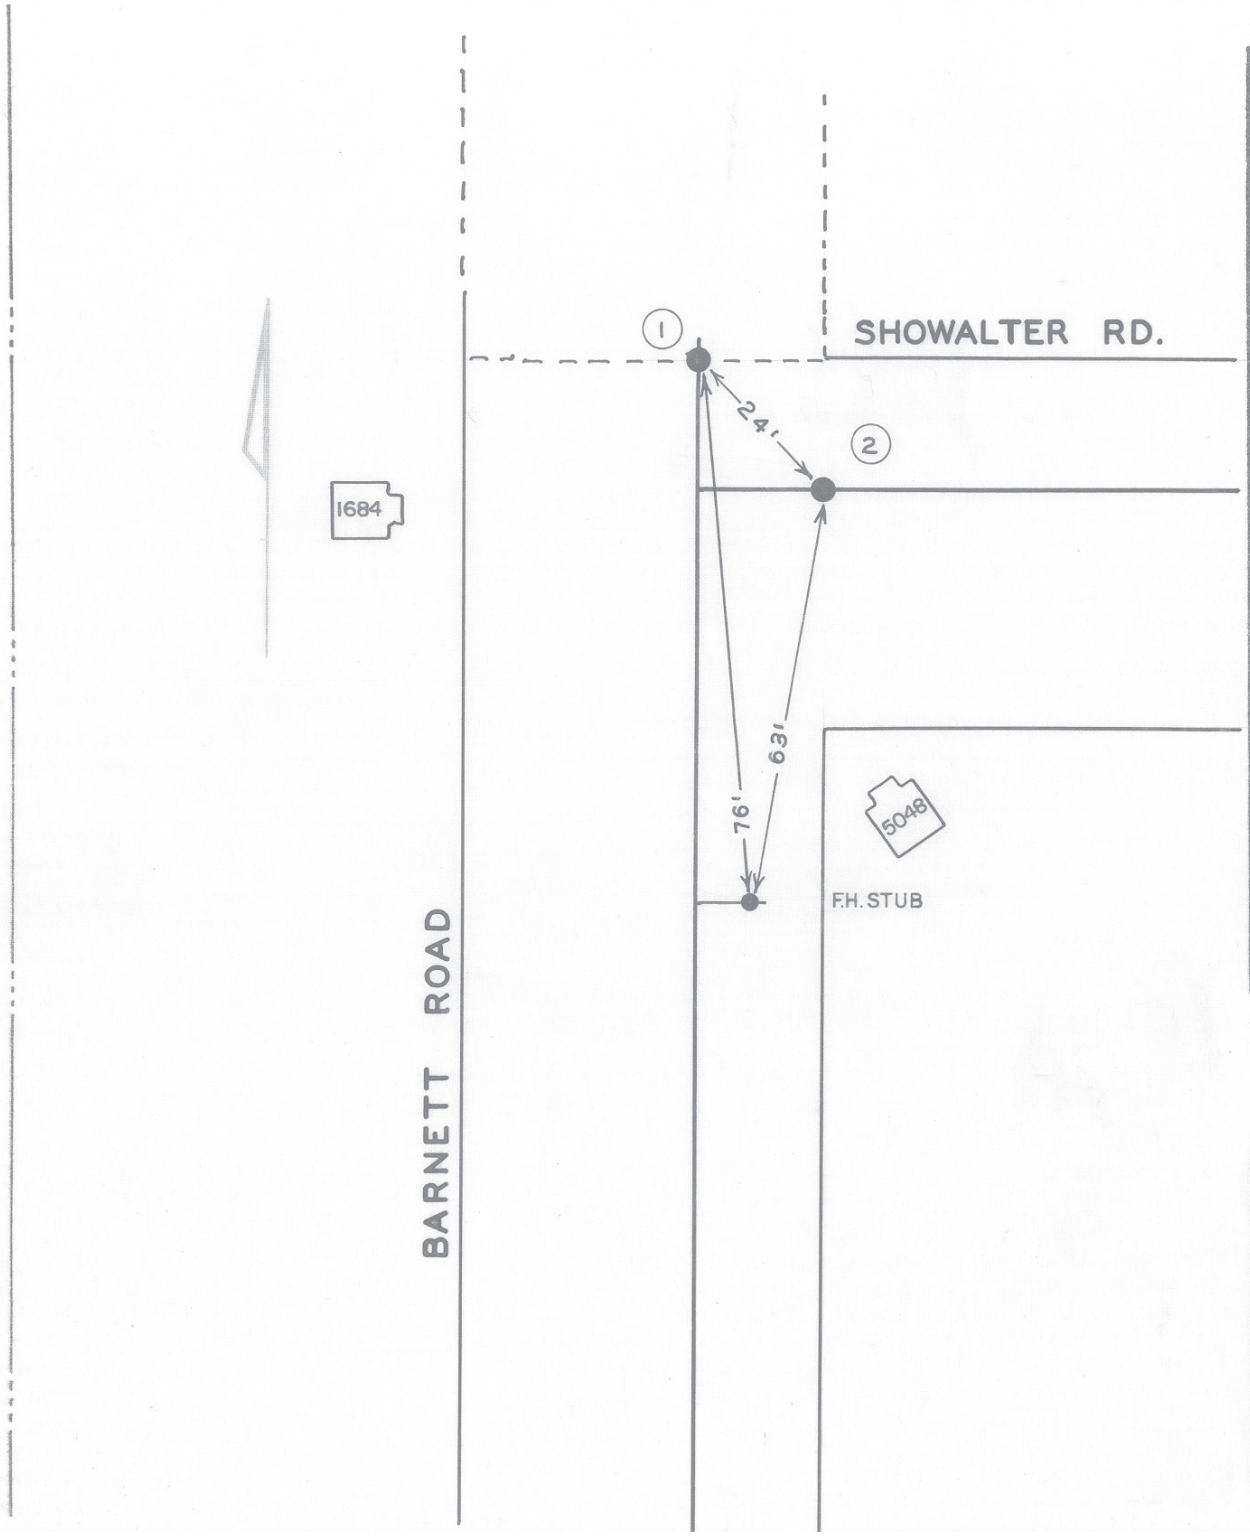

DATE	NO.	SIZE	MAKE	OPEN	TURNS
10-61	1	8'	MUELLER	R	26
10-61	2	6"	MUELLER	R	20
1	1	0	N PL		
	2	0	E PL		

CITY OF ROANOKE — WATER DEPT.

VALVE DIAGRAM

BARNETT ROAD &
SHOWALTER ROAD N.W.

SEC. MAP 613

DATE PAGE NO.