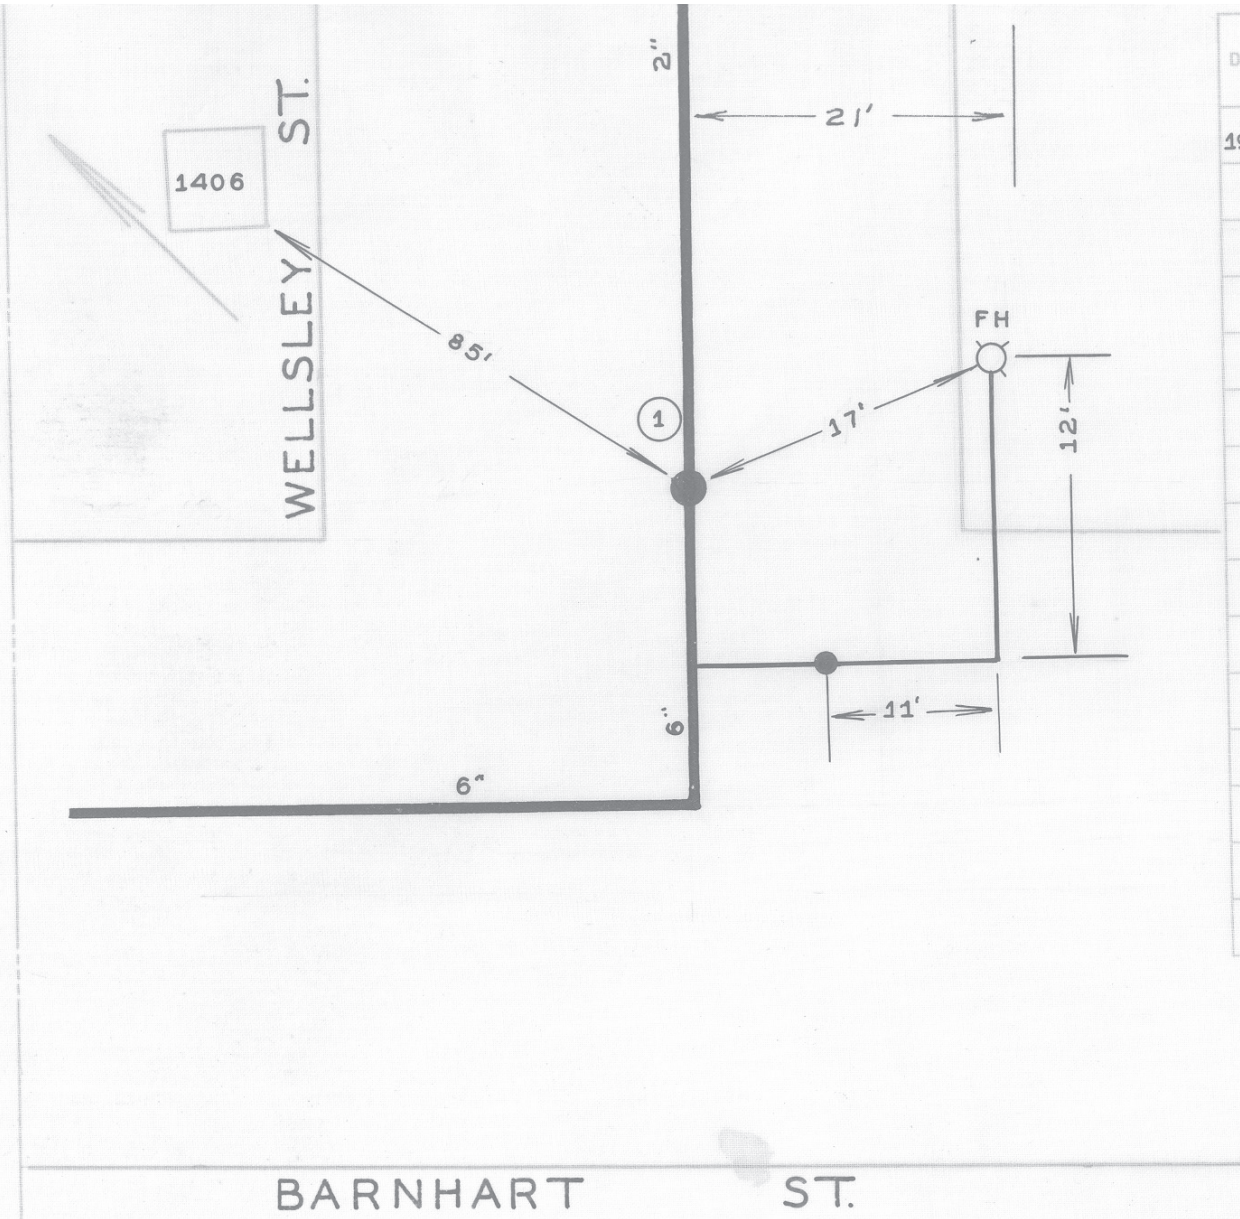

DATE	NO.	SIZE	MAKE	OPEN	TURNS
1949	1	2	DARLING	R	7
	1	10'-N	NPL		

CITY OF ROANOKE—WATER DEP'T

VALVE DIAGRAM

BARNHART STREET &

WELLSLEY STREET N. W.

SEC. MAP 246

DATE

PAGE NO. NW337

2/87 NP