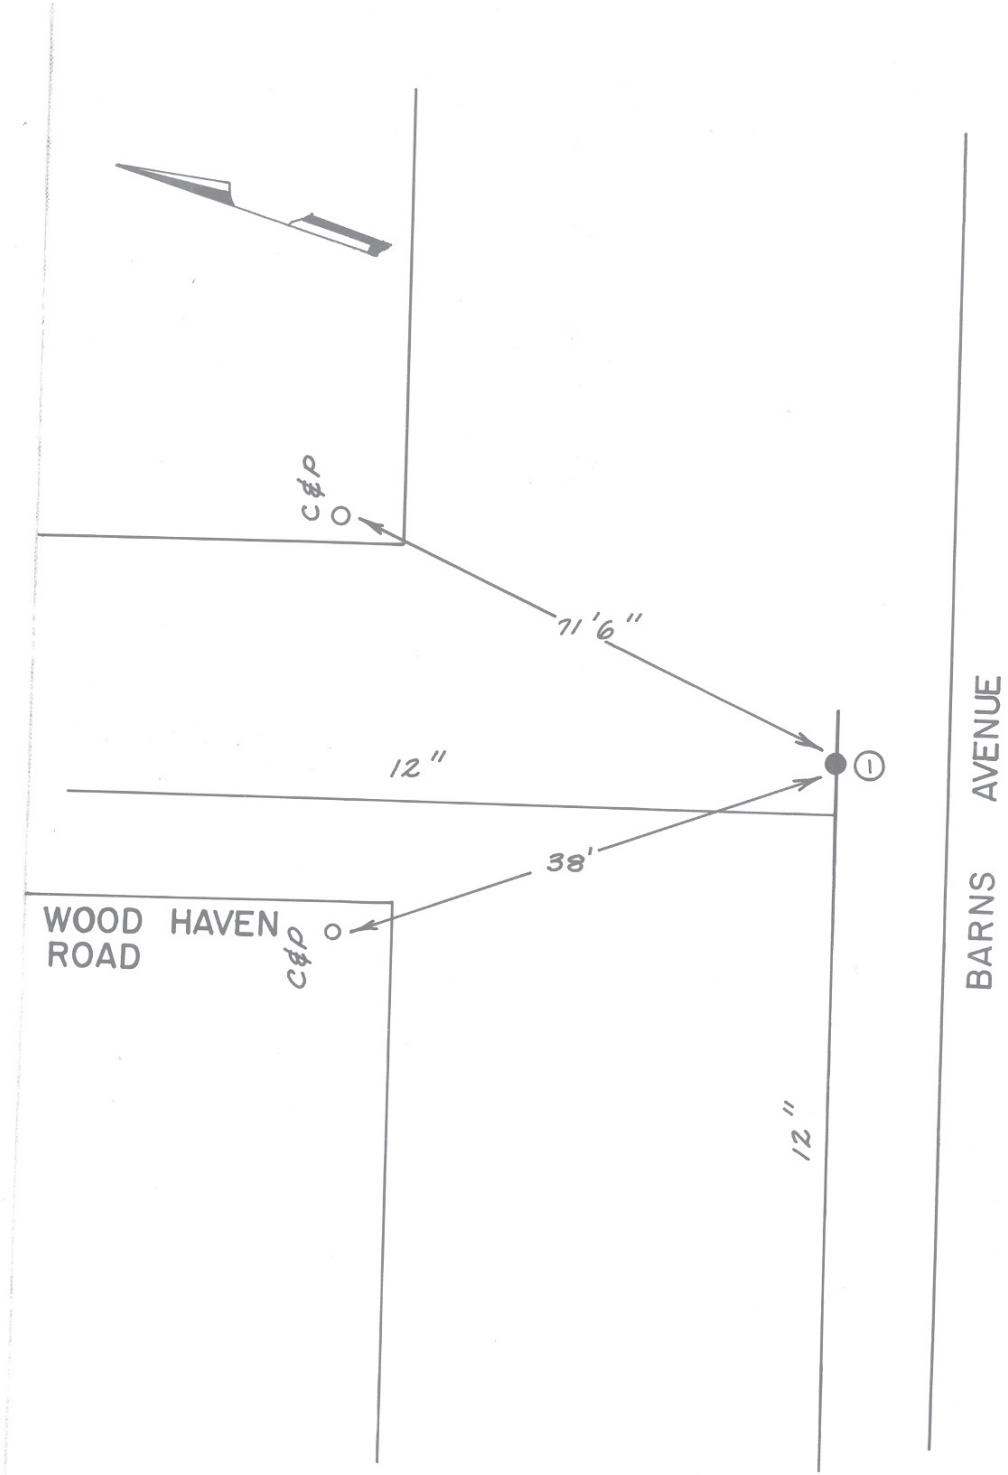

DATE	NO.	SIZE	MAKE	OPEN	TURNS
77	1	12"	MUELLER	R	

CITY OF ROANOKE—WATER DEP'T

VALVE DIAGRAM

BARNS AVENUE &

WOOD HAVEN ROAD

SEC. MAP 660 N.W.

DATE PAGE NO