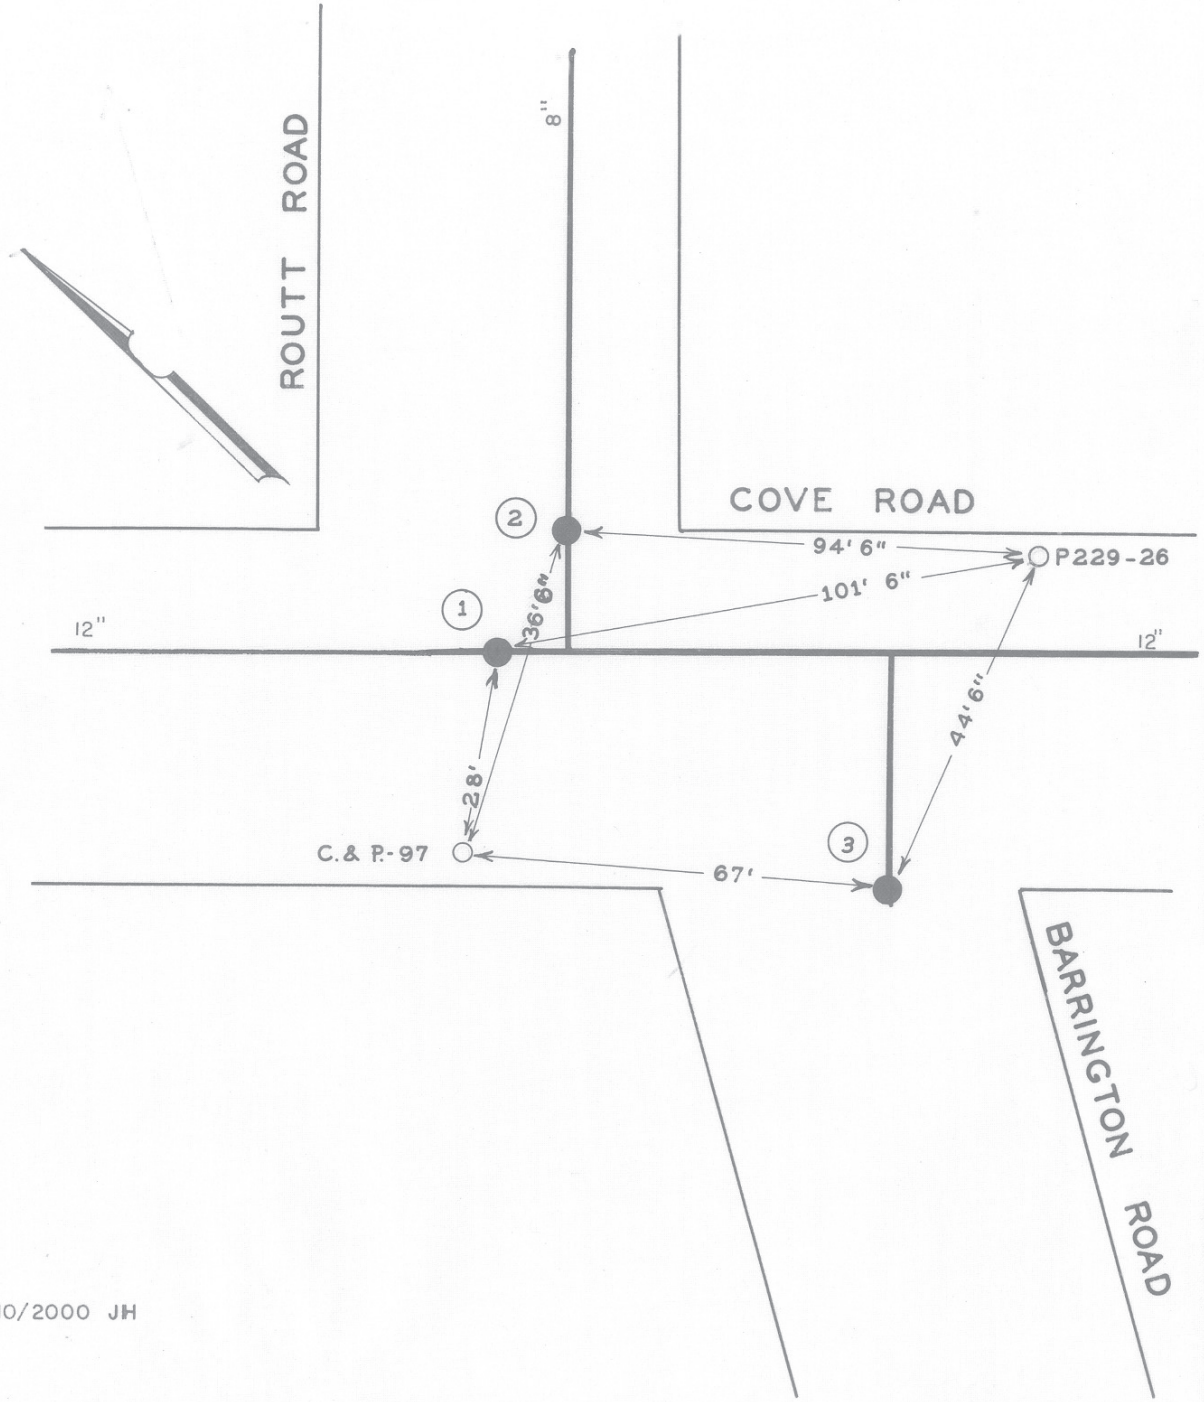


| DATE | NO. | SIZE | MAKE | OPEN | TURNS |
|---|---|---|---|---|---|
| 4-60 | 1 | 12" | MUELLER | R | 38 |
| 4-60 | 2 | 8" | DARLING | R | 27 |
| 4-60 | 3 | 6" | MUELLER | R | 20 |
| | | | | | |
| | | | | | |
| | | | | | |
| | | | | | |
| | | | | | |
| | | | | | |
| | | | | | |
| | | | | | |
| | 1 | 22'W | E.P.L. | | |
| | 2 | 0 | N.P.L. | | |
| | 3 | 0 | S.P.L. | | |
| | | | | | |

CITY OF ROANOKE — WATER DEPT.

VALVE DIAGRAM

BARRINGTON ROAD,

COVE ROAD &

ROUTT ROAD

SEC. MAP 640 N.W.

DATE PAGE NO.

10/2000 JH

"IMPERIAL" TRACING CLOTH. K & E CO., N.Y.