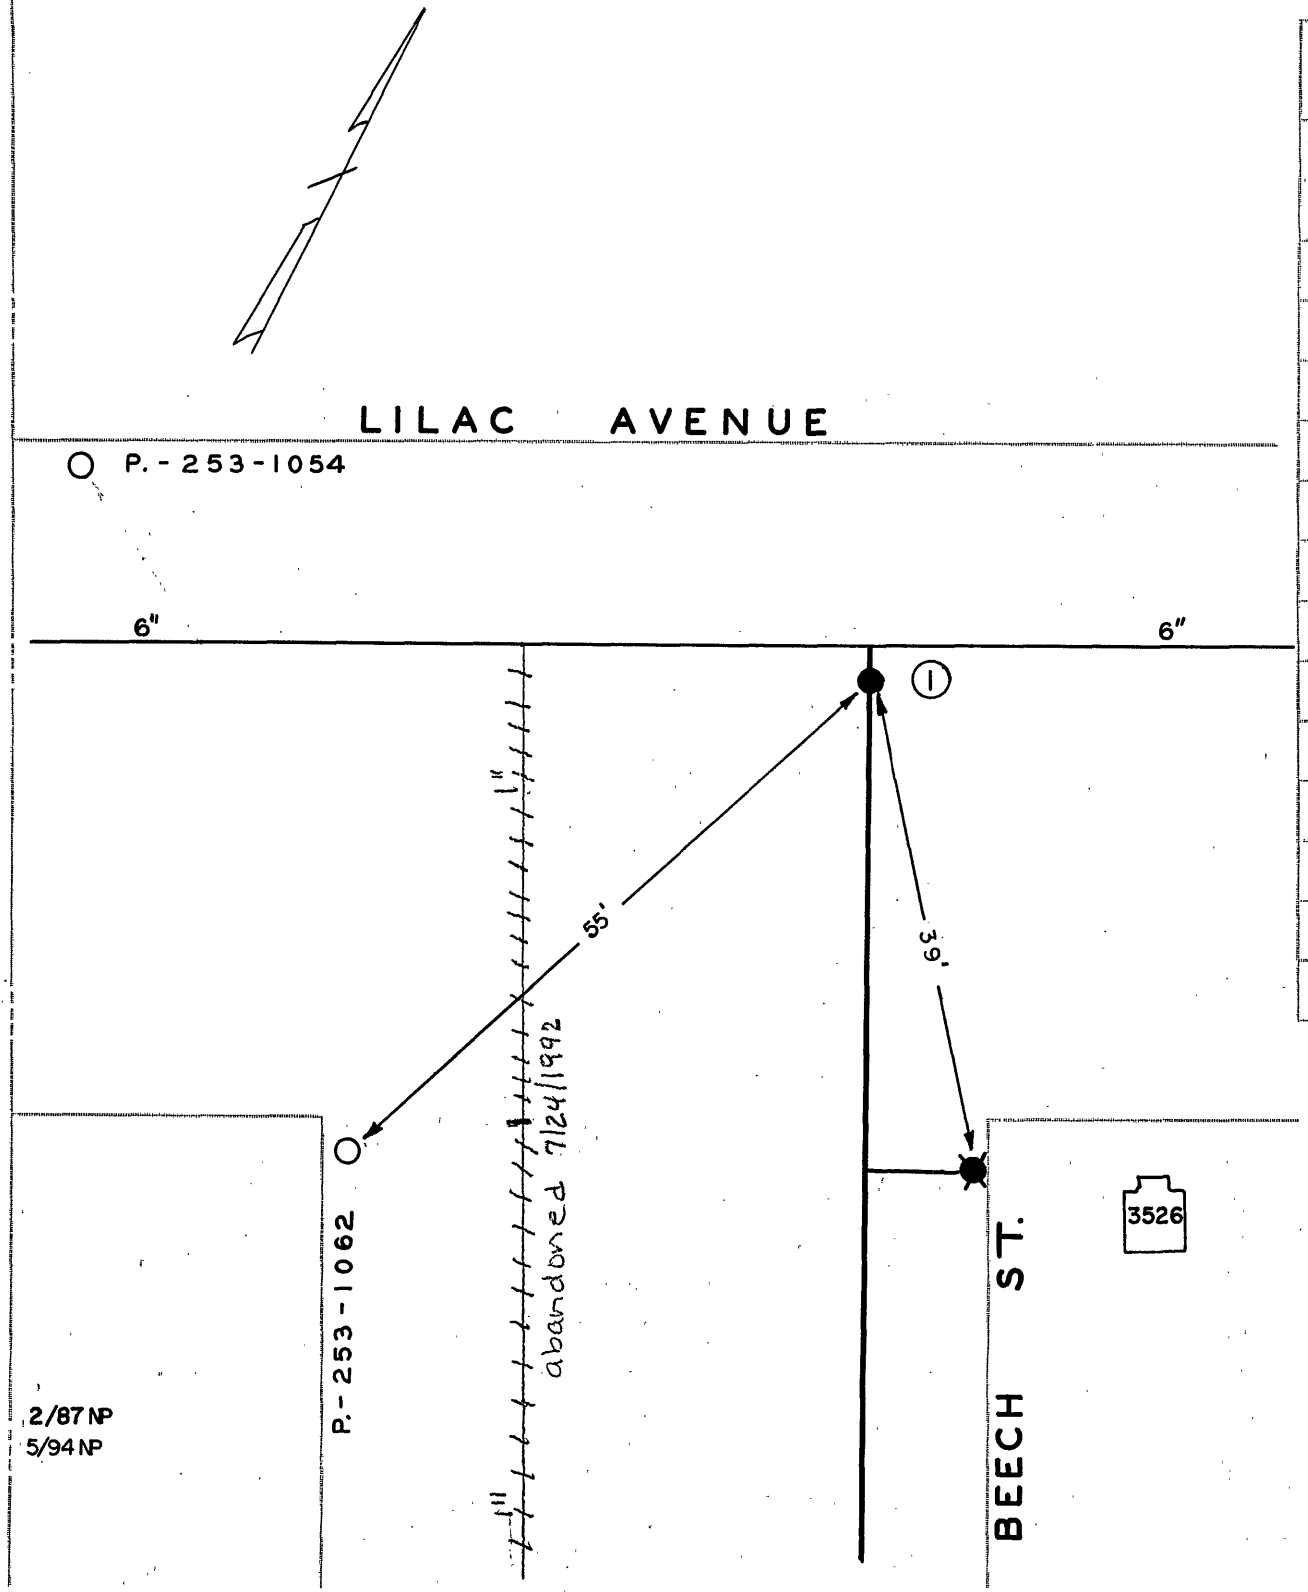

DATE	NO.	SIZE	MAKE	OPEN	TURNS
7-92	1	6"	MUELLER	R	27

CITY OF ROANOKE—WATER DEPT

VALVE DIAGRAM

BEECH STREET &

LILAC AVE. N. W.

EAST INTERSECTION

SEC. MAP 263

DATE PAGE NO.