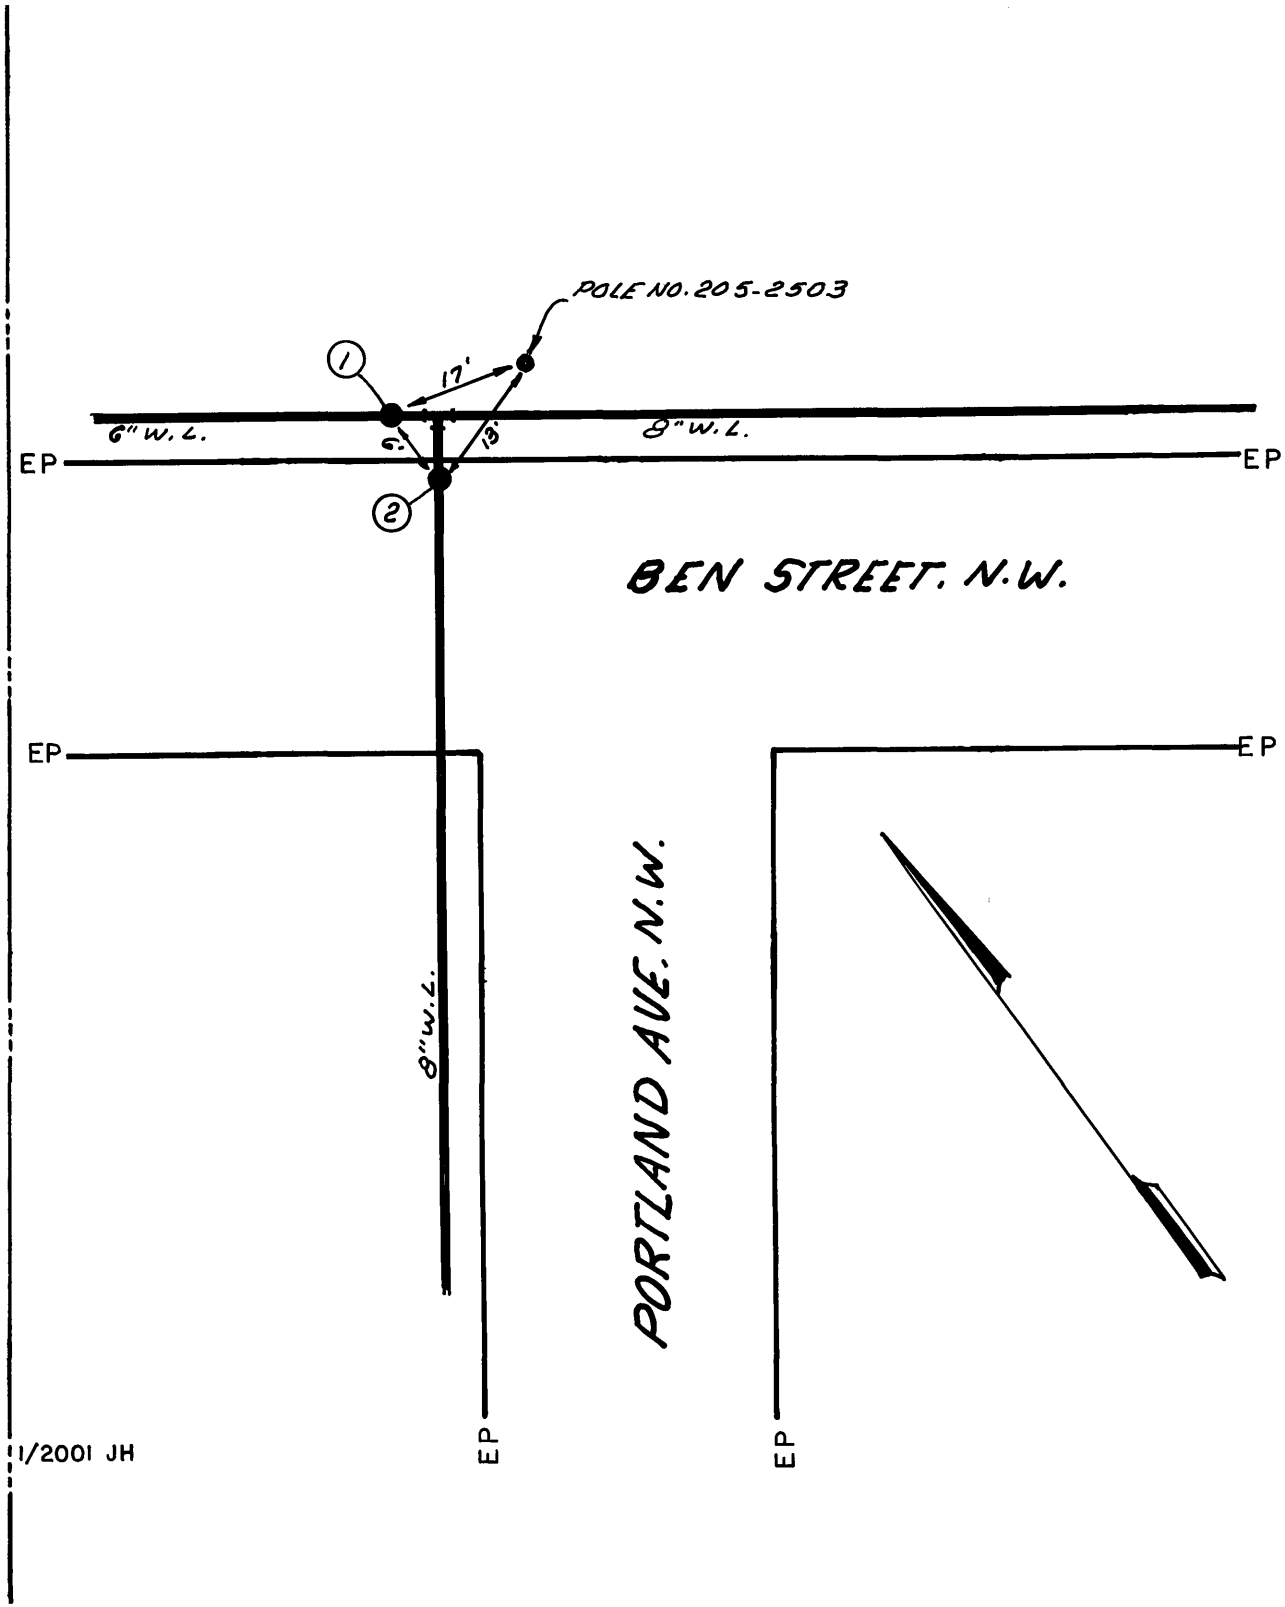

DATE	NO.	SIZE	MAKE	OPEN	TURNS
12/84	1	6"		R	
12/84	1	8"		R	

CITY OF ROANOKE—WATER DEP'T

VALVE DIAGRAM

BEN STREET AND

PORTLAND AVENUE, N.W.

SEC. MAP 642

DATE 4-8-85 PAGE NO.

1/2001 JH