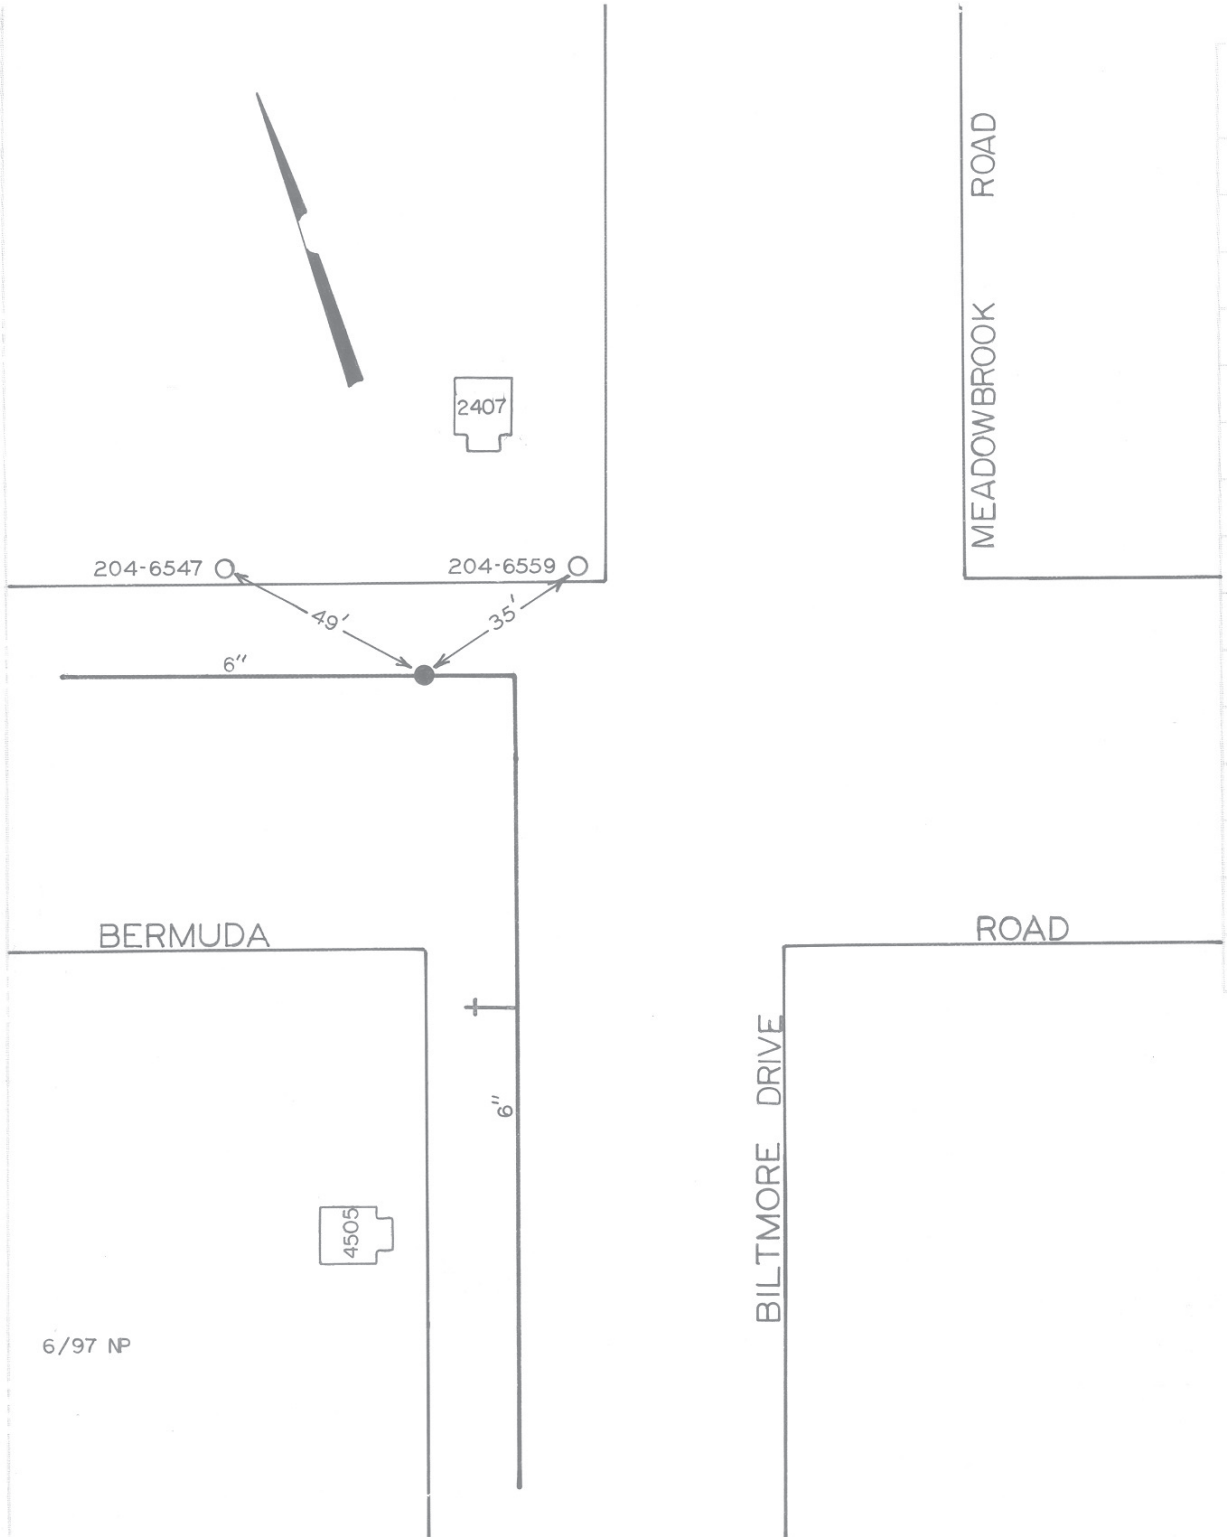

DATE	NO.	SIZE	MAKE	OPEN	TURNS
	1	6"	MUELLER	R	

CITY OF ROANOKE—WATER DEP'T

VALVE DIAGRAM

BERMUDA ROAD &

BILTMORE DRIVE N.W.

SEC. MAP COUNTY 42, 616 (2)

DATE PAGE NO.