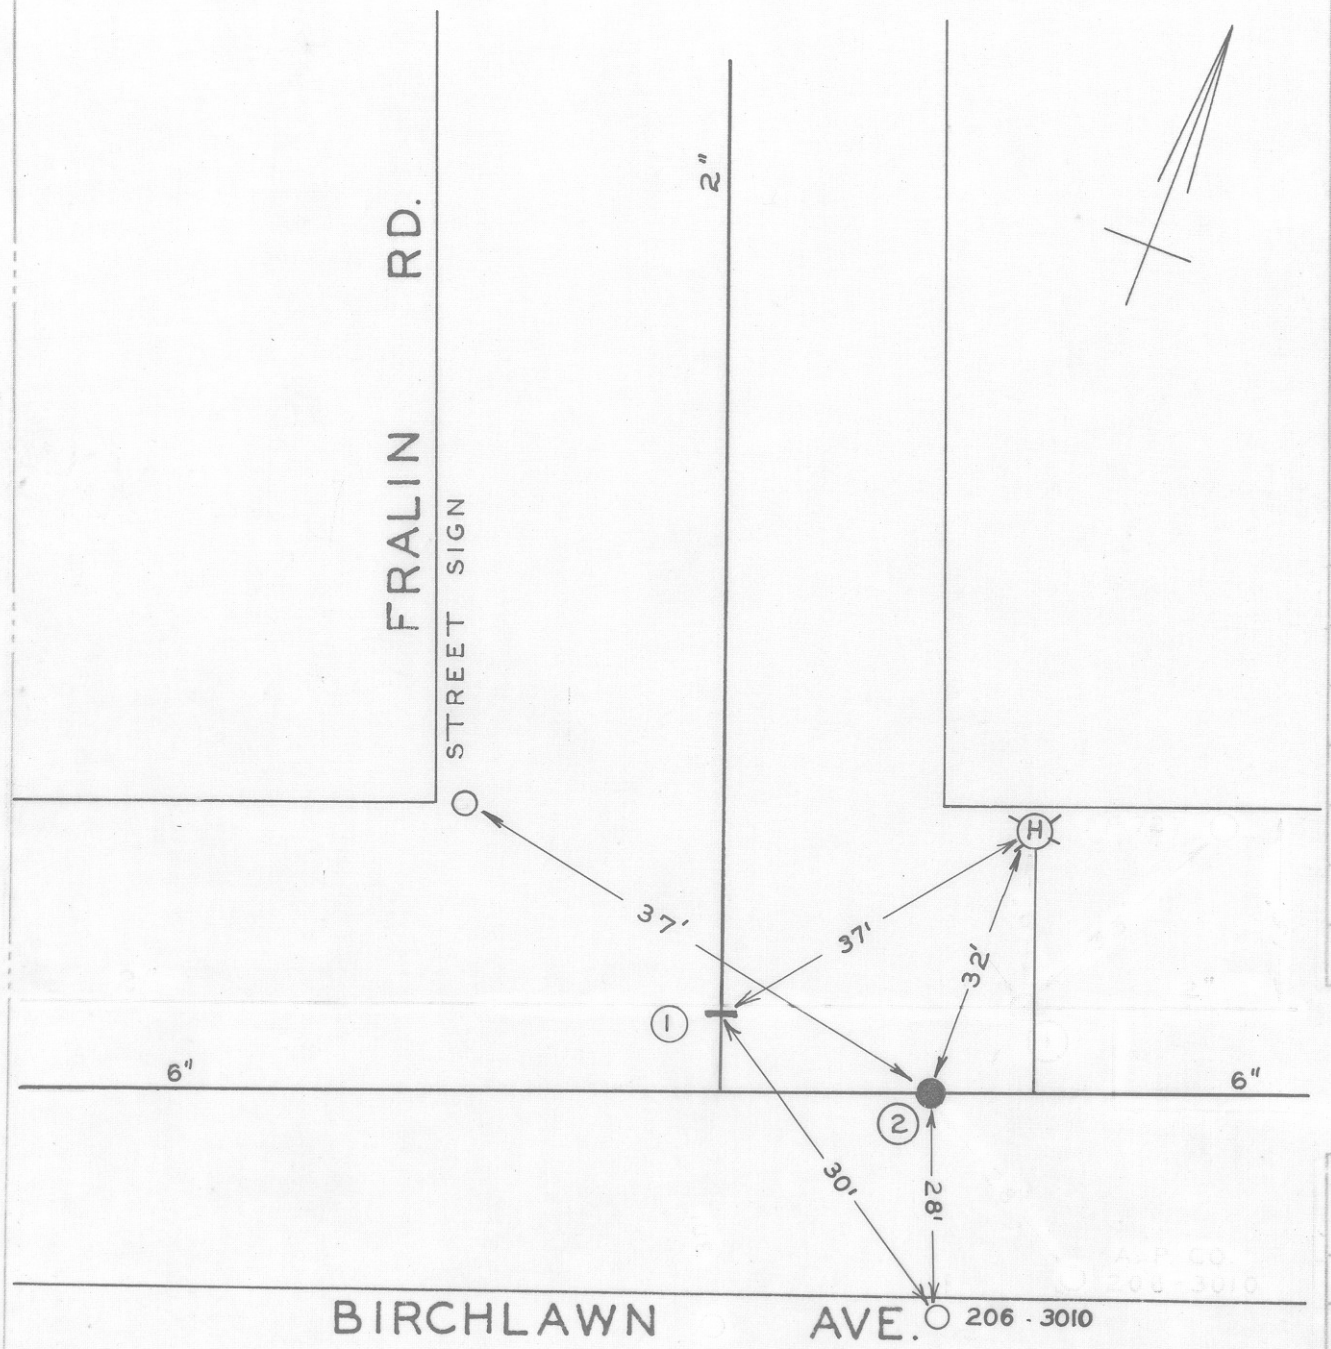

DATE	NO.	SIZE	MAKE	OPEN	TURNS
9-61	1	2"	DARLING	R	
11-52	2	6"	D A R.	R	
	1	15-E	EPL		
	2	0	EPL		

CITY OF ROANOKE—WATER DEPT.

VALVE DIAGRAM

BIRCHLAWN AVE. &

FRALIN RD. N.W.

SEC. MAP 218

DATE PAGE NO.

2/87 NP

"IMPERIAL" TRACING CLOTH
K & E CO., N. Y.