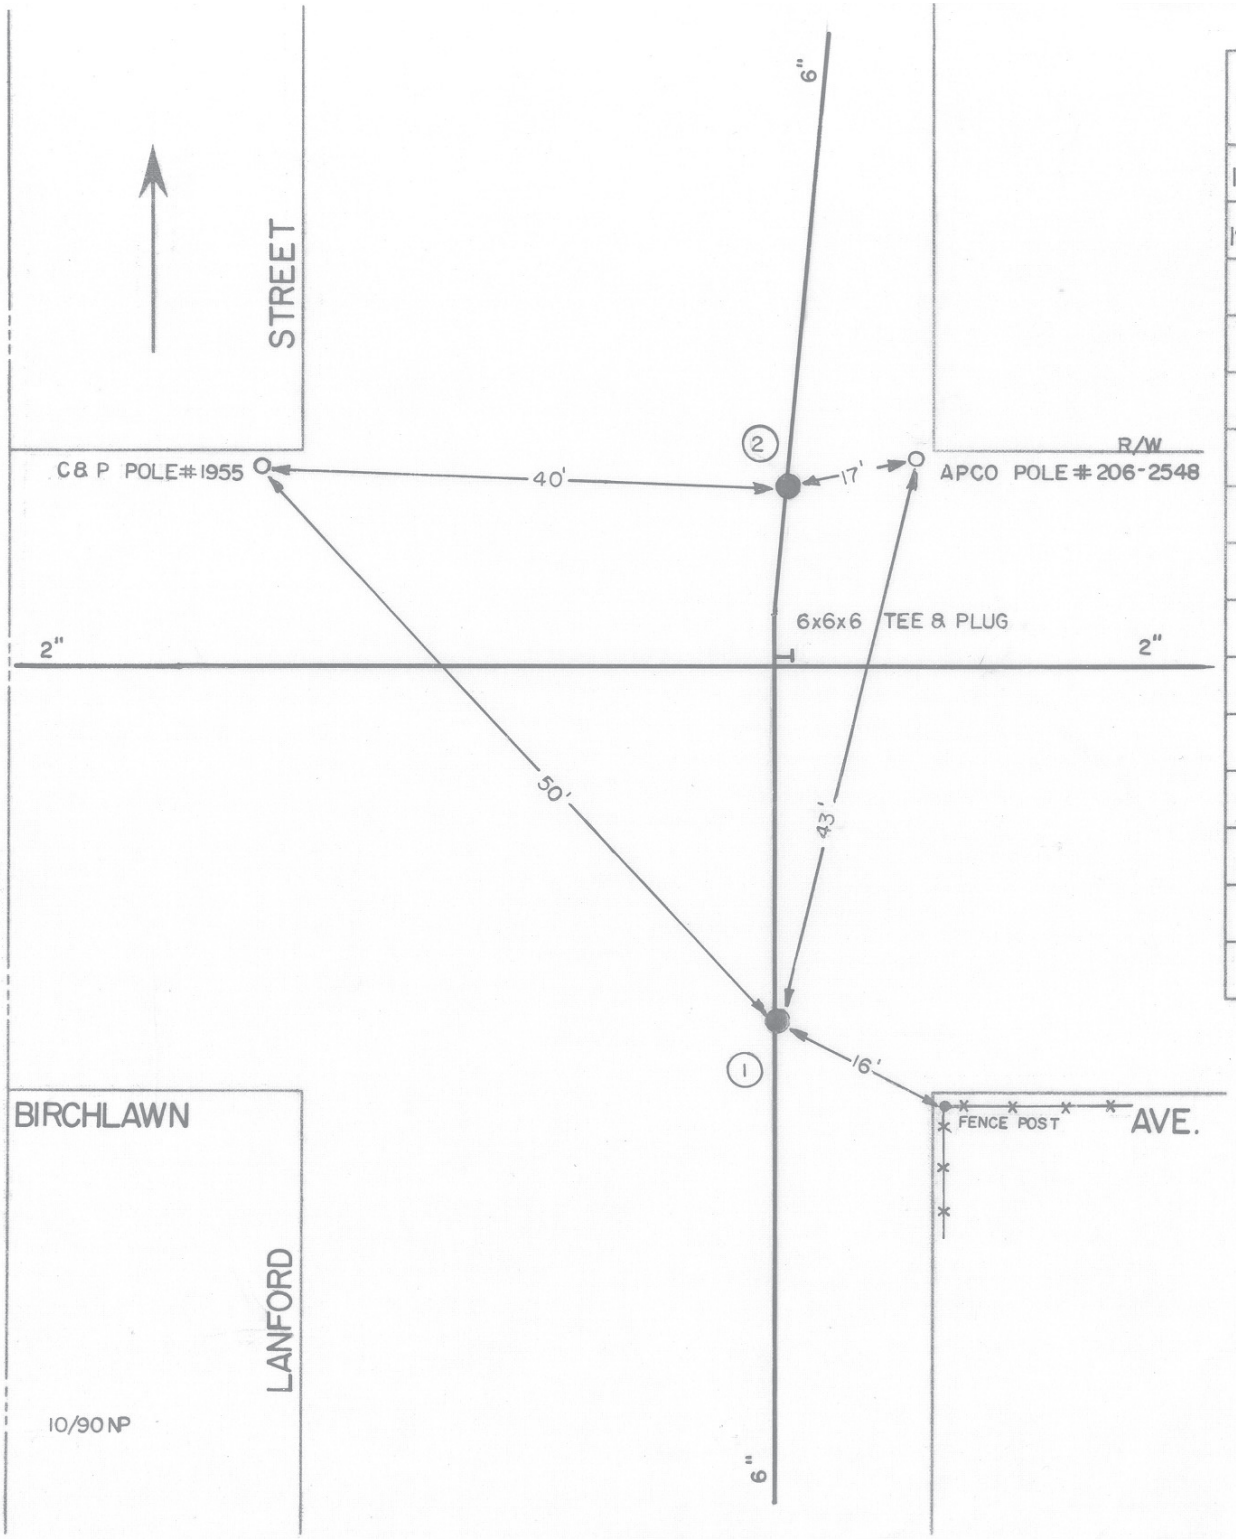

DATE	NO.	SIZE	MAKE	OPEN	TURNS
1986	1	6"			
1986	2	6"			

CITY OF ROANOKE—WATER DEP'T

VALVE DIAGRAM

BIRCHLAWN AVENUE

LANFORD STREET

N.W.

SEC. MAP 217

DATE PAGE NO.