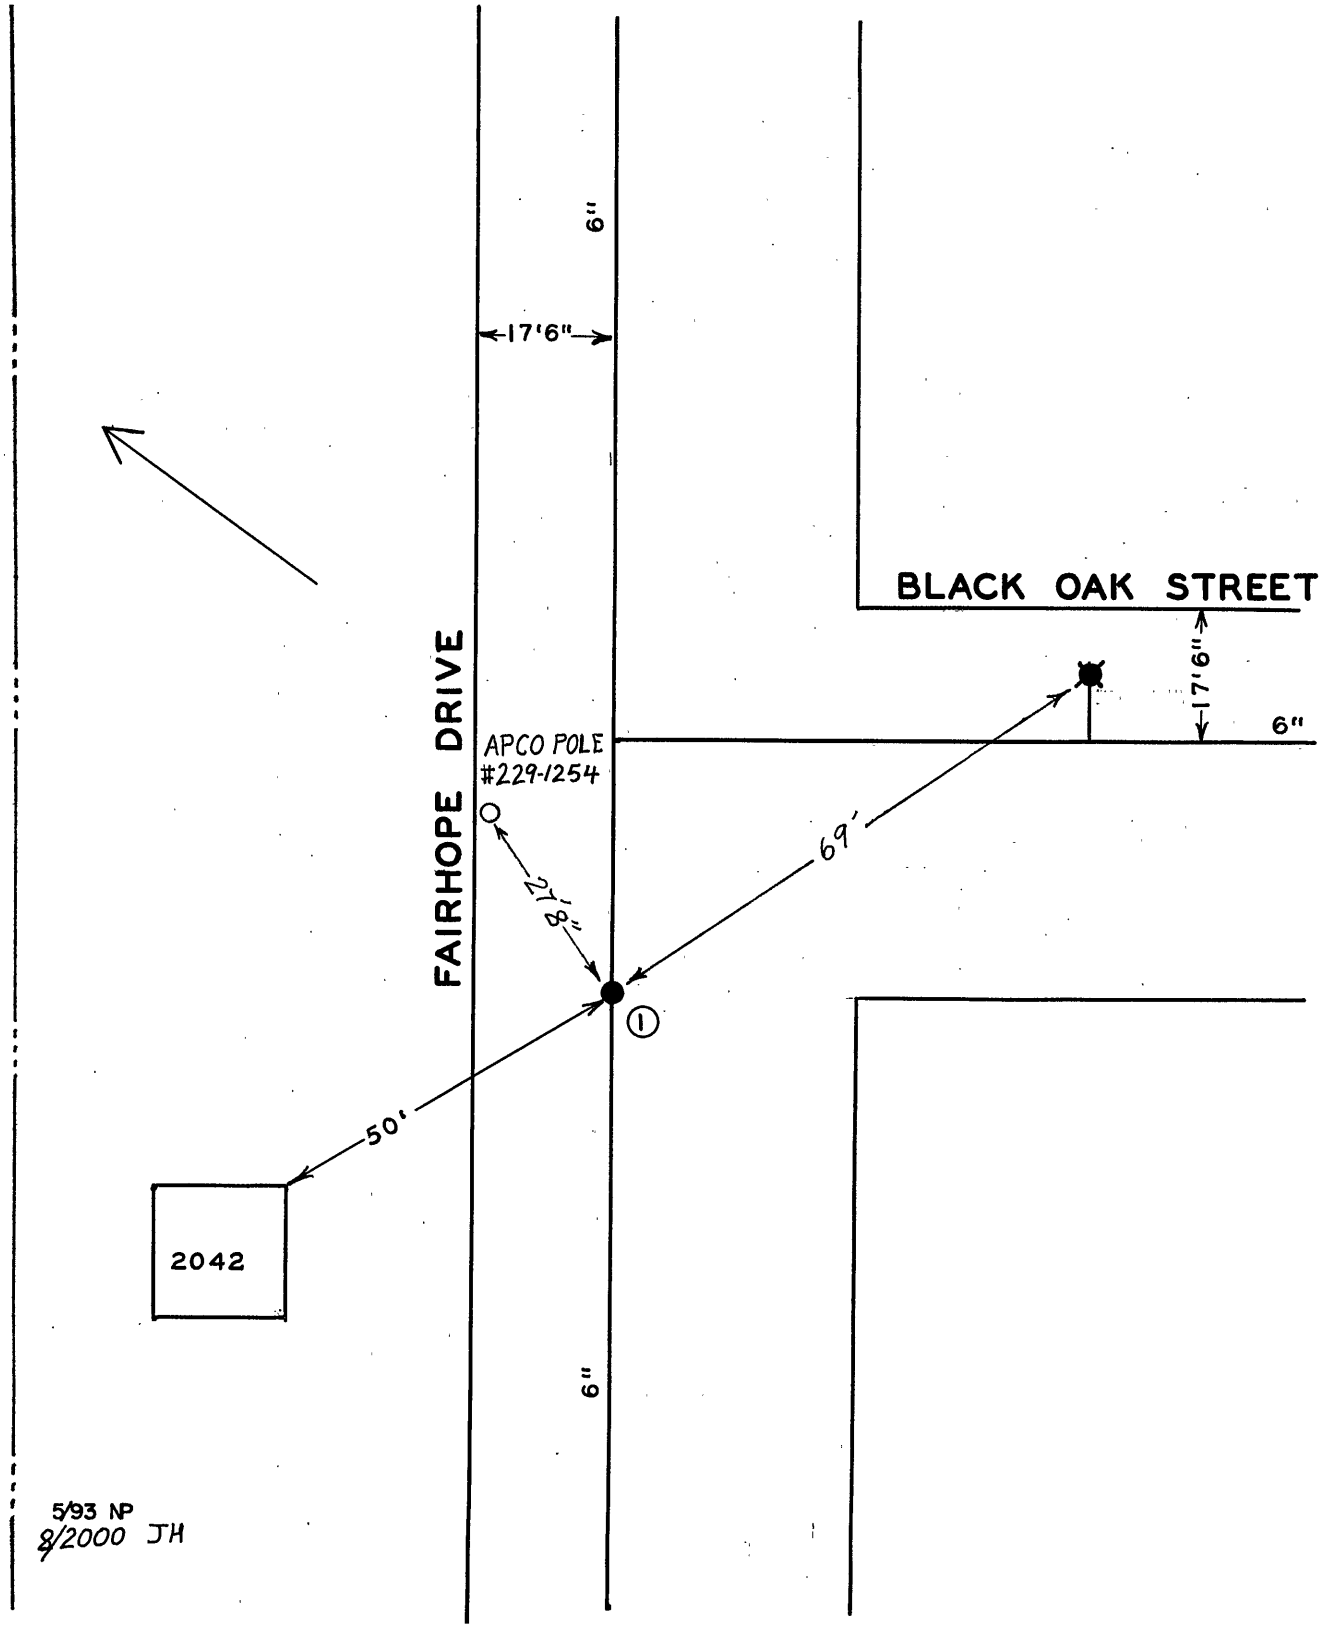

DATE	NO.	SIZE	MAKE	OPEN	TURNS
6-62	1	6"	MUELLER	R	20
	1	0	S.P.L.		

CITY OF ROANOKE—WATER DEPT.

VALVE DIAGRAM

BLACK OAK STREET &

FAIRHOPE DRIVE N.W.

SEC. MAP 640

DATE **PAGE NO.**

5/93 NP
8/2000 JH