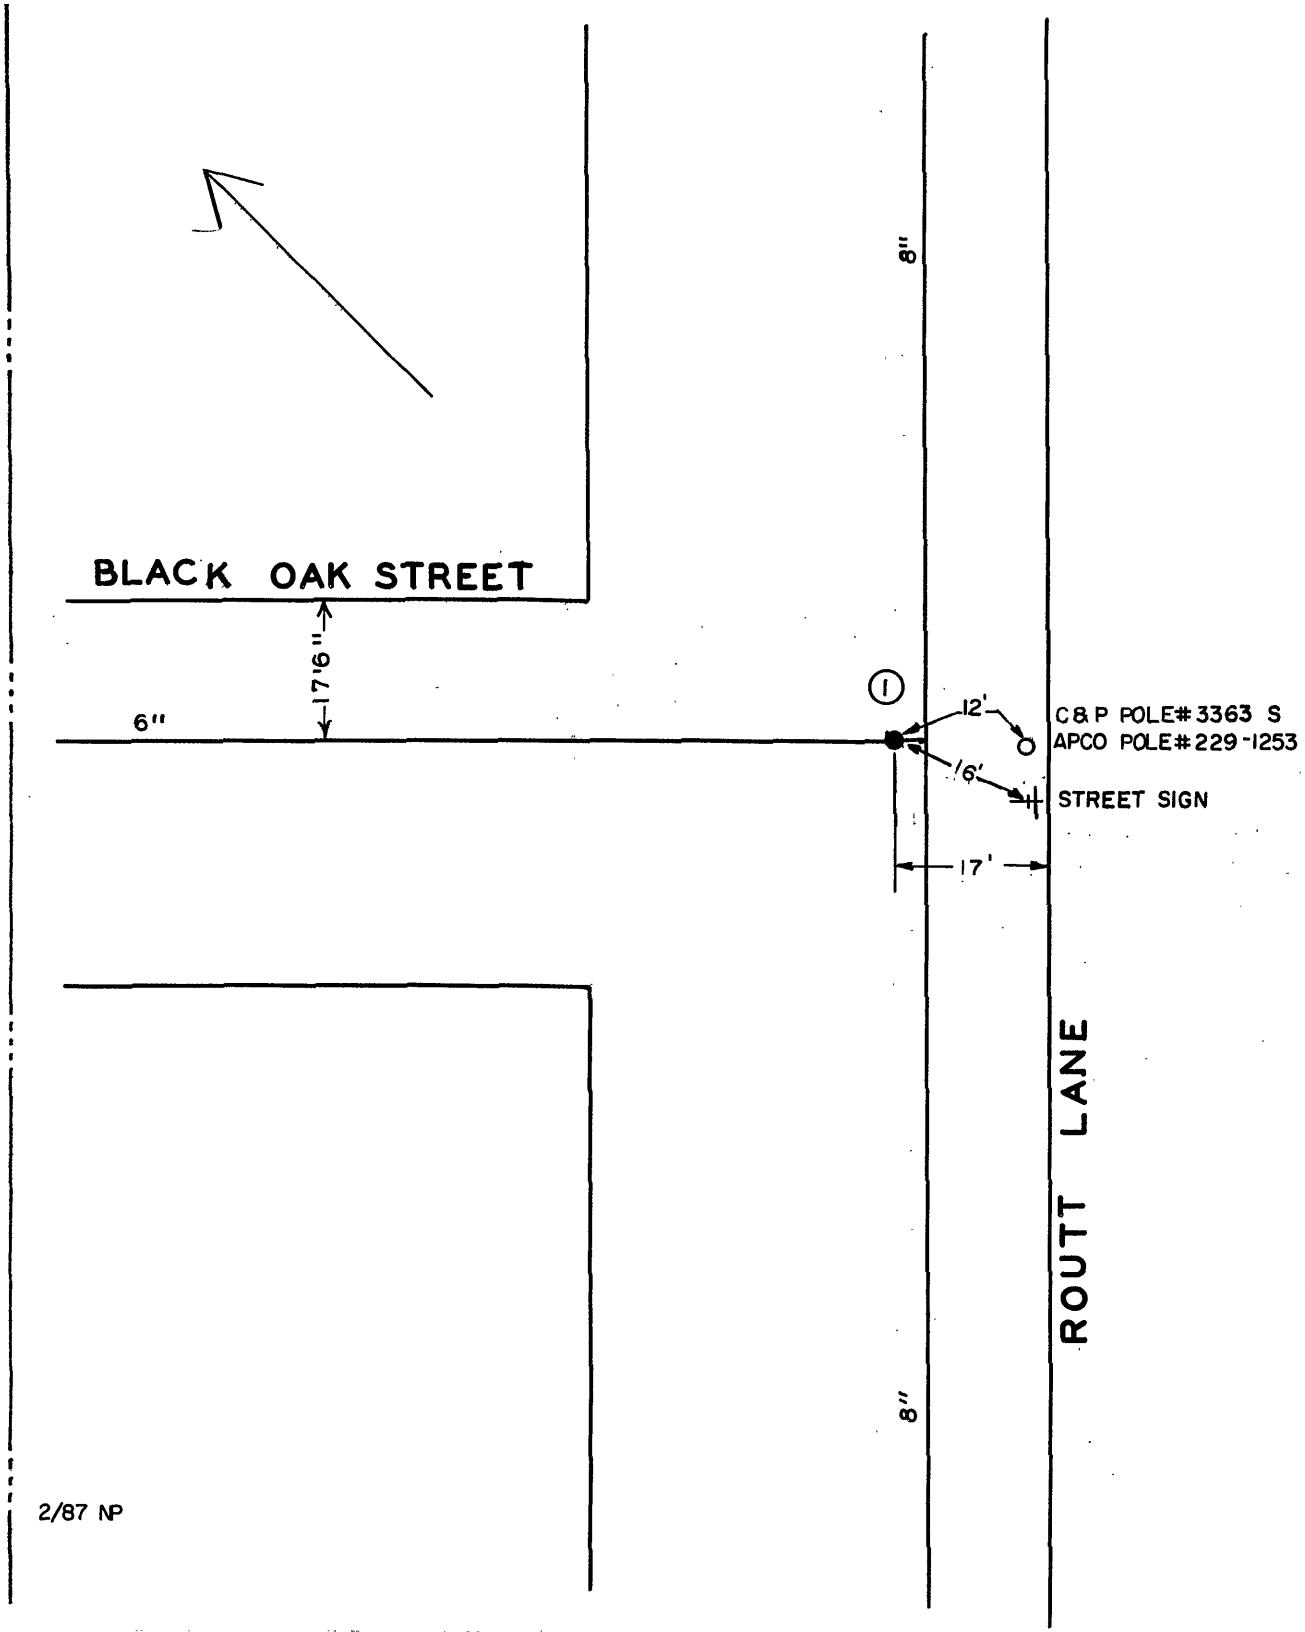

DATE	NO.	SIZE	MAKE	OPEN	TURNS
6-62	1	6	DARLING	R	20
	1	17'W	E.P.L.		

CITY OF ROANOKE—WATER DEPT.

VALVE DIAGRAM

BLACK OAK STREET &
ROUTT LANE N.W.

SEC. MAP 640

DATE **PAGE NO.**

2/87 NP