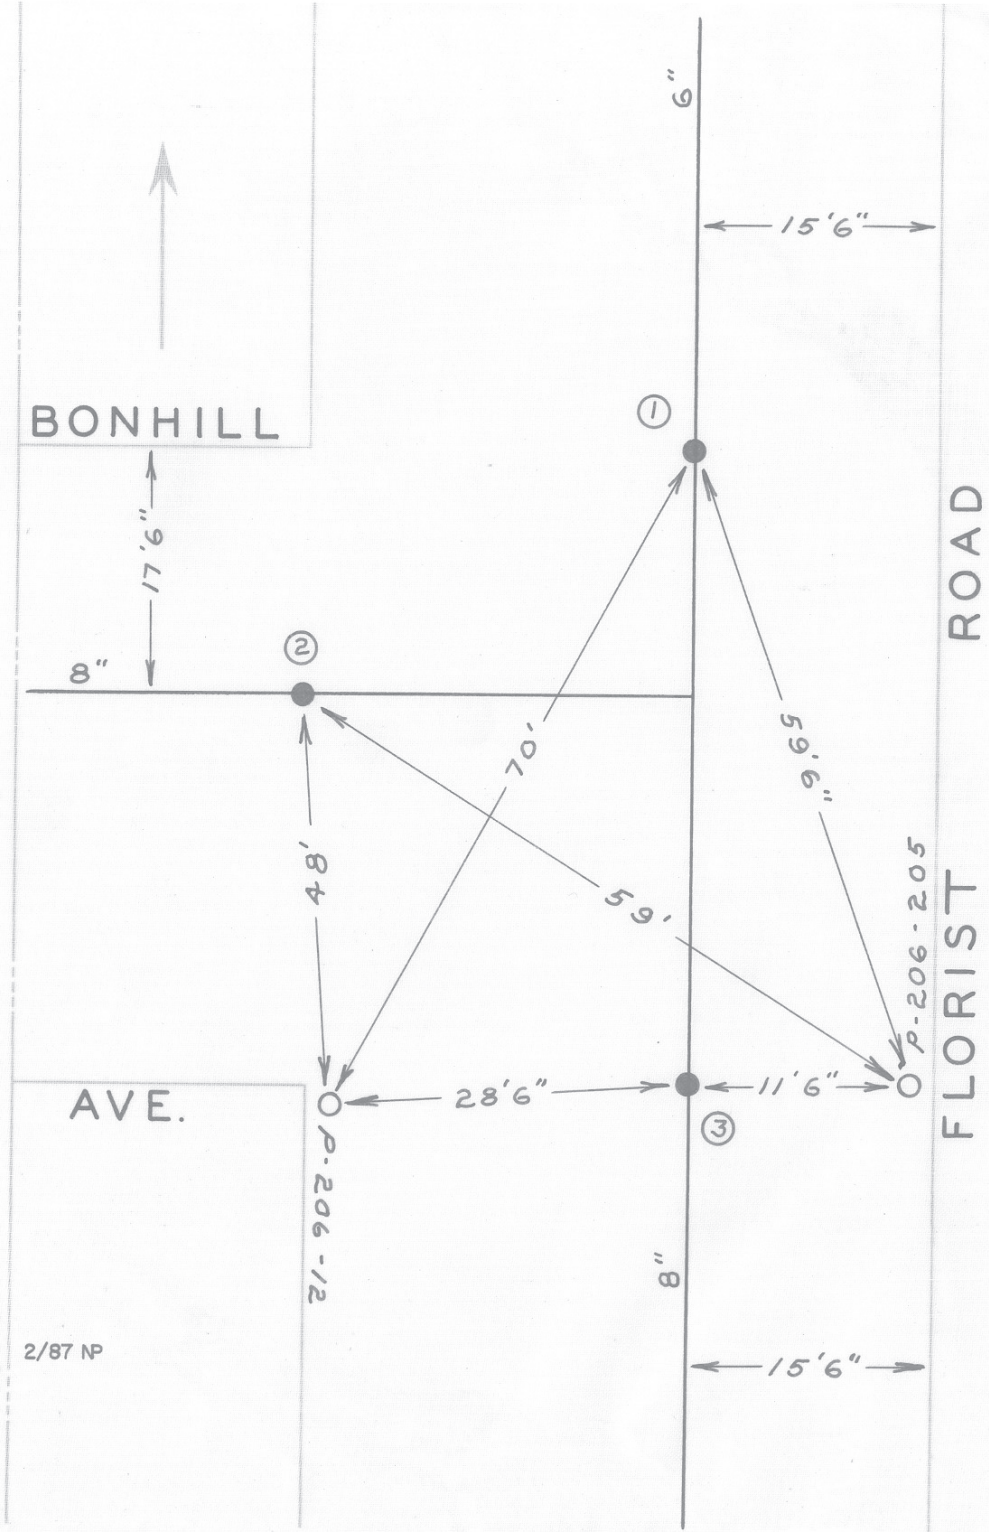

DATE	NO.	SIZE	MAKE	OPEN	TURNS
57	1	6"	MUELLER	R	20½
57	2	8"	DARLING	R	26
57	3	8"	DARLING	R	26
	1	0	NPL		
	2	0	WPL		
	3	0	SPL		

CITY OF ROANOKE—WATER DEP'T

VALVE DIAGRAM

BONHILL AVE. &

FLORIST RD. N.W.

SEC. MAP 220

DATE PAGE NO.