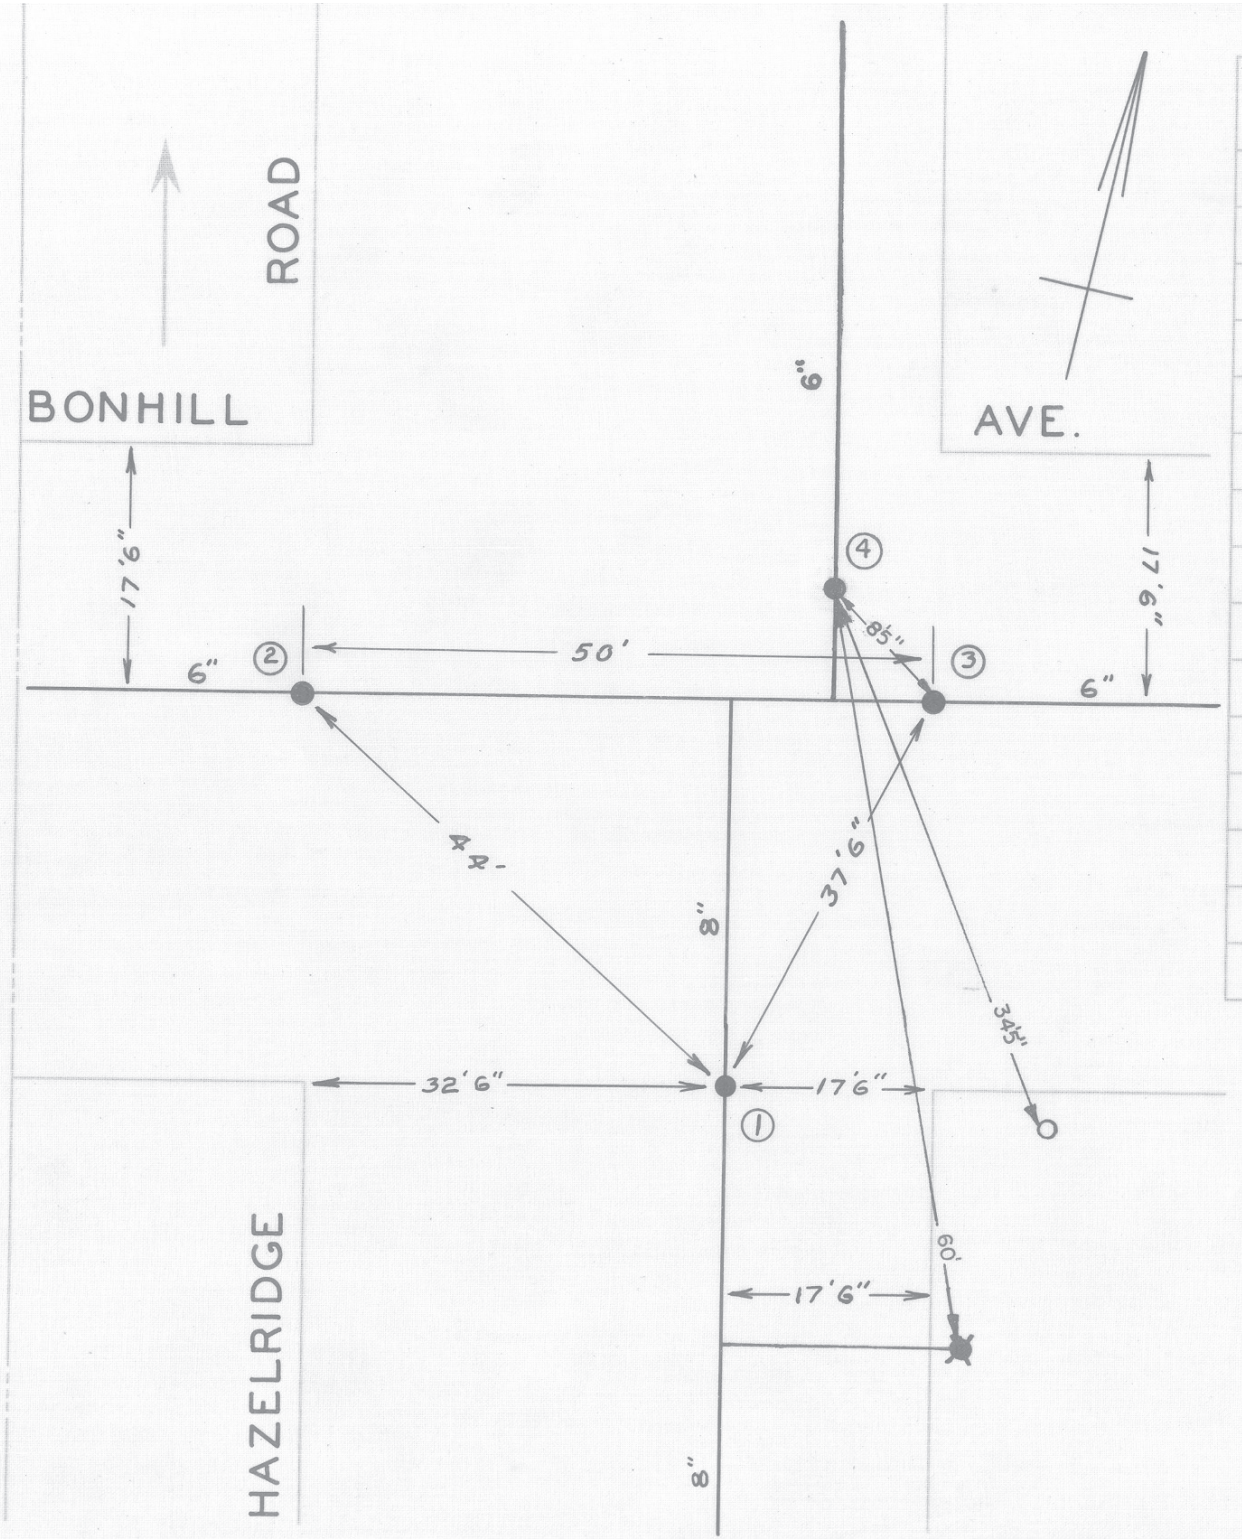

DATE	NO.	SIZE	MAKE	OPEN	TURNS
56	1	8"	MUELLER	R	
57	2	6"	DARLING	R	20
57	3	6"	MUELLER	R	20½
78	4	6"			
	1	0	SPL		
	2	0	WPL		
	3	0	EPL		

CITY OF ROANOKE—WATER DEP'T

VALVE DIAGRAM

BONHILL AVE. &

HAZELRIDGE RD. N.W.

SEC. MAP 220

DATE PAGE NO.

9/88 NP